

1507

WILDLIFE AND COUNTRYSIDE ACT 1981

City of Bath Definitive Map and Statement

Bath and North East Somerset Council (City of Bath Definitive Map and Statement Modification Order) (No. 11 – Bathwick & Combe Down) 2015

This Order is made by Bath and North East Somerset Council under section 53(2)(b) of the Wildlife and Countryside Act 1981 ('the Act') because it appears to that authority that the City of Bath Definitive Map and Statement require modification in consequence of the occurrence of an event specified in section 53(3)(c)(i), namely, that rights of way which are not shown in the map and statement subsist or are reasonably alleged to subsist over land in the area to which the map relates, being rights of way such that the land over which the rights subsist are public paths or bridleways.

The authority has consulted with every local authority whose area includes the land to which the order relates. The Bath and North East Somerset Council hereby order that:


1. For the purposes of this order the relevant date is 14th April 2015.
2. The City of Bath Definitive Map and Statement shall be modified as described in Part I and Part II of the Schedule and shown on the maps attached to the Order.
3. This order shall take effect on the date it is confirmed and may be cited as the Bath and North East Somerset Council (City of Bath Definitive Map and Statement Modification Order) (No. 11 - Bathwick and Combe Down) 2015.

Given under the Common Seal of the Bath and North East Somerset Council the 12th day of August 2015.

The COMMON SEAL of the
BATH AND NORTH EAST SOMERSET
COUNCIL
was hereunto affixed
in the presence of:-

Muriel Shaw

Authorised signatory

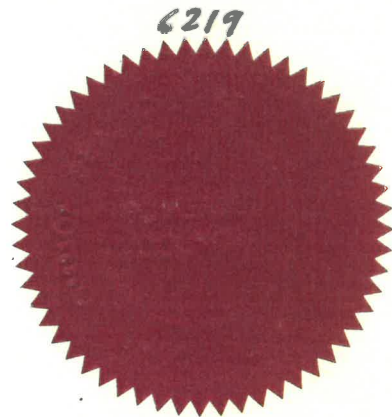

The foregoing order is hereby confirmed
subject to the red ink modifications thereon

Heidi Cruickshank 30 MAY 2017

An Inspector appointed by The Secretary
of State for Environment, Food and
Rural Affairs

In pursuance of its powers conferred by Schedule 15 of the Wildlife and Countryside Act 1981, the Council confirms the above Order. However, that part of the order which relates to Footpaths BC54/40 and BC64/1 is to be treated as having been severed from this order and will be treated as a separate order. It will therefore not form part of this order for confirmation purposes.

The COMMON SEAL of
BATH AND NORTH EAST SOMERSET
COUNCIL
was hereunto affixed
this 20th day of January 2016
in the presence of:-

Mimi Lacey

Authorised signatory



SCHEDULE

PART I

Modification of Definitive Map

Description of paths or ways to be added

BC54/39

A footpath in Bath and North East Somerset running from point A at Grid Reference ST 7589 6466 on public footpath BC54/40 and continuing in a generally north-north-easterly direction for a distance of approximately 31 metres to where it finishes at point B on Darlington Place at Grid Reference ST 7590 6469 and shown by a broken black line with short intervals marked A-B on the map numbered Part 1 annexed to this order, the number of this footpath to be known as BC54/39.

BC54/40

A footpath in Bath and North East Somerset running from point A at Grid Reference ST 7586 6465 on Sydney Buildings and continuing up steps for a distance of approximately 36 metres in a generally east-north-easterly direction to point B at Grid Reference ST 7589 6466 where it is joined by public footpath BC54/39. The footpath continues for a distance of approximately 8 metres to where the direction changes to generally easterly at point C at Grid Reference ST 7590 6466. The footpath continues for a distance of approximately 8 metres to point D at Grid Reference ST 7591 6466 where the steps end. The footpath continues for a distance of approximately 107 metres to point E at Grid Reference ST 7601 6466 where the direction changes to generally south-easterly at its junction with public footpath BC64/2. The footpath continues for a distance of approximately 357 metres to point F at Grid Reference ST 7632 6448 where the direction changes to generally south-westerly at the junction with public footpath BC64/6. The footpath continues for a distance of approximately 4 metres to a gate at point G at Grid Reference ST 7632 6447. The footpath continues for a distance of approximately 189 metres to point H at Grid Reference ST 7622 6431 where the direction changes to generally southerly. The footpath continues for a distance of approximately 8 metres to point I at Grid Reference ST 7622 6430 where steps start. The footpath continues for a distance of approximately 51 metres to where the steps end at a gate at point J at Grid Reference ST 7620 6426. The footpath continues for a distance of approximately 93 metres, through point K at Grid Reference ST 7620 6424 to where it finishes on footpath CQ42 at point L at Grid Reference ST 7621 6417 and shown by a broken black line with short intervals marked A-B-C-D-E-F-G-H-I-J-K-L on the map numbered Part 2 annexed to this order, the number of this footpath to be known as BC54/40.

BC63/2

A footpath in Bath and North East Somerset running from point A at Grid Reference ST 7678 6377 on restricted byway BC62/1 and continuing for a distance of approximately 431 metres in a generally south-easterly direction to a stone stile at point B at Grid Reference ST 7720 6370. The footpath continues for a distance of approximately 17 metres to point C at Grid Reference ST 7722 6369 where it finishes on public footpath BC73/2 and shown by a broken black line with short intervals marked A-B-C on the map numbered Part 3 annexed to this order, the number of this footpath to be known as BC63/2.

BC64/1

A footpath in Bath and North East Somerset running from point A at Grid Reference ST 7648 6488 on public footpath AQ36 and continuing for a distance of approximately 53 metres in a generally north-easterly direction to a kissing gate at point B at Grid Reference ST 7653 6490 running through Point C at Grid Reference ST 7653 6491, Point D at Grid Reference ST 7653 6491, Point E at Grid Reference ST 7654 6491, Point F at Grid Reference ST 7654 6491, Point G at Grid Reference ST 7656 6491 to Point H at Grid Reference ST 4658 6490 where the direction changes to generally southerly. The footpath continues for a distance of approximately 17 metres to point I at Grid Reference ST 7657 6489 where the direction changes to generally south-easterly. The footpath continues for a distance of approximately 8 metres to point J at Grid Reference ST 7658 6488 where the direction changes to generally southerly. The footpath continues for a distance of approximately 6 metres to point K at Grid Reference ST 7658 6488 where the direction changes to generally south-easterly. The footpath continues for a distance of approximately 19 metres to point M at Grid Reference ST 7659 6486 where it finishes on public footpath BA1/20 at Grid Reference ST 7659 6486 and shown by a broken black line with short intervals marked A-B-C-D-E-F-G-H-I-J-K-L-M on the map numbered Part 4 annexed to this order, the number of this footpath to be known as BC64/1.

BC64/2

A footpath in Bath and North East Somerset running from point A at Grid Reference ST 7601 6466 on public footpath BC54/40 and continuing in a generally north-easterly direction for a distance of approximately 43 metres to where it finishes at point B on Bathwick Hill at Grid Reference ST 7604 6469 and shown by a broken black line with short intervals marked A-B on the map numbered Part 5 annexed to this order, the number of this footpath to be known as BC64/2.

BC64/3

A footpath in Bath and North East Somerset running from point A at Grid Reference ST 7657 6466 on public footpath BA1/20 and continuing for a distance of approximately 264 metres in a generally south-easterly direction to where it finishes on North Road at point B at Grid Reference ST 7671 6444 and shown by a broken black line with short intervals marked A-B on the map numbered Part 6 annexed to this order, the number of this footpath to be known as BC64/3.

BC64/4

A footpath in Bath and North East Somerset running from point A at Grid Reference ST 7677 6447 on public bridleway BC74/4 and continuing for a distance of approximately 31 metres in a generally north-westerly direction to point B at Grid Reference ST 7675 6449 where steps start. The footpath continues up the steps for a distance of approximately 19 metres to where the steps end at point C at Grid Reference ST 7675 6451. The footpath continues for a distance of approximately 34 metres to point D at Grid Reference ST 7675 6455 where the direction changes to generally north-easterly. The footpath continues for a distance of approximately 22 metres to point E at Grid Reference ST 7677 6456 where it is joined by public footpaths BA1/38, BA1/39 and BC64/5. The footpath continues for a distance of approximately 172 metres to where it finishes on public bridleway BC74/4 at point F at Grid Reference ST 7689 6468 and shown by a broken black line with short intervals marked A-B-C-D-E-F on the map numbered Part 7 annexed to this order, the number of this footpath to be known as BC64/4.

BC64/5

A footpath in Bath and North East Somerset running from point A at Grid Reference ST 7677 6456 on public footpaths BC64/4, BA1/38 and BA1/39 and continuing for a distance of approximately 4 metres in a generally south-easterly direction to point B at Grid Reference ST 7677 6456 where a footbridge starts. The footpath continues along the footbridge for a distance of approximately 22 metres to where it ends at point C at Grid Reference ST 7679 6455. The footpath continues for a distance of approximately 374 metres to point D at Grid Reference ST 7707 6430 where the direction changes to generally south-south-easterly. The footpath continues for a distance of approximately 17 metres to point E where it finishes on Soldier Down Lane at Grid Reference ST 7707 6429 and shown by a broken black line with short intervals marked A-B-C-D-E on the map numbered Part 8 annexed to this order, the number of this footpath to be known as BC64/5.

BC64/6

A footpath in Bath and North East Somerset running from point A at Grid Reference ST 7632 6448 on public footpath BC54/40 and continuing in a generally northerly direction for a distance of approximately 35 metres to where it finishes at point B on Bathwick Hill at Grid Reference ST 7633 6451 and shown by a broken black line with short intervals marked A-B on the map numbered Part 9 annexed to this order, the number of this footpath to be known as BC64/6.

BC65/5

A footpath in Bath and North East Somerset running from steps at point A at Grid Reference ST 7642 6574 on Warminster Road and continuing in a generally south-easterly direction for a distance of approximately 3 metres to where the steps end at point B at Grid Reference ST 7643 6574. The footpath continues for a distance of approximately 24 metres to where it finishes on Minster Way at point C at Grid Reference ST 7644 6572 and shown by a broken black line with short intervals marked A-B-C on the map numbered Part 10 annexed to this order, the number of this footpath to be known as BC65/5.

BC65/6

A footpath in Bath and North East Somerset running from point A at Grid Reference ST 7608 6549 on Warminster Road and continuing for a distance of approximately 20 metres in a generally south-south-easterly direction to point B at Grid Reference ST 7609 6547 where the direction changes to generally east-south-easterly. The footpath continues for a distance of approximately 23 metres to where it finishes on St Christopher's Close at point C at Grid Reference ST 7612 6547 and shown by a broken black line with short intervals marked A-B-C on the map numbered Part 11 annexed to this order, the number of this footpath to be known as BC65/6.

BC65/7

A footpath in Bath and North East Somerset running from point A at Grid Reference ST 7624 6504 on Cleveland Walk and continuing for a distance of approximately 118 metres in a generally east-south-easterly direction to steps at point B at Grid Reference ST 7636 6502. The footpath continues up the steps for a distance of approximately 3 metres to where it finishes on North Road at point C at Grid Reference ST 7636 6502 and shown by a broken black line with short intervals marked A-B-C on the map numbered Part 12 annexed to this order, the number of this footpath to be known as BC65/7.

BC72/1

A footpath in Bath and North East Somerset running from point A at Grid Reference ST 7766 6294 on public footpath AQ96c and continuing for a distance of approximately 203 metres in a generally south-easterly direction to a kissing gate at point B at Grid Reference ST 7783 6283. The footpath continues for a distance of approximately 58 metres to where the direction changes to generally north-easterly at point C at Grid Reference ST 7788 6281. The footpath continues for a distance of approximately 4 metres to a kissing gate at point D at Grid Reference ST 7789 6281 where the direction changes to generally south-easterly. The footpath continues for a distance of approximately 55 metres to where it finishes on steps on Brassknocker Hill at point E at Grid Reference ST 7793 6278 and shown by a broken black line with short intervals marked A-B-C-D-E on the map numbered Part 13 annexed to this order, the number of this footpath to be known as BC72/1.

BC73/2

A footpath in Bath and North East Somerset running from a pedestrian gate on Claverton Down Road at point A at Grid Reference ST 7717 6398 and continuing for a distance of approximately 291 metres in a generally southerly direction to point B at Grid Reference ST 7722 6370 where it is joined by public footpath BC63/2. The footpath continues for a distance of approximately 7 metres to a stone stile at point C at Grid Reference ST 7722 6369 where the direction changes to generally south-easterly. The footpath continues for a distance of approximately 14 metres to a field boundary at point D at Grid Reference ST 7723 6368. The footpath continues for a distance of approximately 240 metres to a field boundary at point E at Grid Reference ST 7741 6353. The footpath continues for a distance of approximately 158 metres to a pedestrian gate at point F at Grid Reference ST 7753 6342 where the direction changes to generally southerly. The footpath continues for a distance of approximately 278 metres to point G at Grid Reference ST 7749 6315 where the direction changes to generally south-south-easterly. The footpath continues for a distance of approximately 228 metres to where it finishes at

a stone stile on Claverton Down Road at point H at Grid Reference ST 7762 6296 and shown by a broken black line with short intervals marked A-B-C-D-E-F-G-H on the map numbered Part 14 annexed to this order, the number of this footpath to be known as BC73/2.

BC73/3

A bridleway in Bath and North East Somerset running from point A at Grid Reference ST 7792 6360 on Claverton Down Road and continuing for a distance of approximately 469 metres in a generally northerly direction to point B at Grid Reference ST 7804 6403 where it finishes on Claverton Hill and shown by a broken black line with crossbars in the intervals marked A-B on the map numbered Part 15 annexed to this order, the number of this bridleway to be known as BC73/3.

BC74/2

A footpath in Bath and North East Somerset running from point A at Grid Reference ST 7758 6447 on public footpath AQ210 and continuing for a distance of approximately 181 metres in a generally north-easterly direction to point B at Grid Reference ST 7774 6456 where the direction changes to generally northerly. The footpath continues for a distance of approximately 18 metres to point C at Grid Reference ST 7745 6458 where it finishes on public bridleway BC74/1 and shown by a broken black line with short intervals marked A-B-C on the map numbered Part 16 annexed to this order, the number of this footpath to be known as BC74/2.

BC74/5

A footpath in Bath and North East Somerset running from point A at Grid Reference ST 7773 6373 on Claverton Down Road and continuing in a generally northerly direction through point C at Grid Reference ST 7774 6377 for a distance of approximately 360 metres to point B at Grid Reference ST 7781 6408 where it finishes on The Avenue and shown by a broken black line with short intervals marked A-B-C on the map numbered Part 17 annexed to this order, the number of this footpath to be known as BC74/5.

PART II
Modification of Definitive Statement
Variation of particulars of path or way

A new Statement shall be recorded for BC54/39 as follows:

Path Number: BC54/39

Status: Footpath
Length: Approximately 31 metres
Ward / Parish: Bathwick
Width: Varies between 3.8 metres – 6.7 metres, as shown shaded grey on the map numbered Part 1 included in the Bath and North East Somerset Council (City of Bath Definitive Map and Statement Modification Order) (No.11 – Bathwick & Combe Down) 2015.

Description of Route			
From		General Direction	
County Road or Right of Way	Grid Reference	To	
		County Road or Right of Way	Grid Reference
Public Footpath BC54/40	ST 7589 6466	NNE Darlington Place	ST 7590 6469

General Description:

The footpath starts on public footpath BC54/40 and continues for a distance of approximately 31 metres in a generally north-north-easterly direction to where it finishes on Darlington Place.

Conclusive Evidential Provisions	
Conditions and Limitations	Position
None	

PART II
Modification of Definitive Statement
Variation of particulars of path or way

A new Statement shall be recorded for BC54/40 as follows:

Path Number: BC54/40

Status: Footpath
Length: Approximately 861 metres
Ward / Parish: Bathwick
Width: Varies between 0.7 metres – 4.4 metres, as shown shaded grey on the map numbered Part 2 included in the Bath and North East Somerset Council (City of Bath Definitive Map and Statement Modification Order) (No.11 – Bathwick & Combe Down) 2015.

Description of Route			
From		General Direction	
County Road or Right of Way	Grid Reference	To	
		County Road or Right of Way	Grid Reference
Sydney Buildings	ST 7586 6465	SW	Footpath CQ42
			ST 7621 6417

General Description:

The footpath starts on Sydney Buildings and continues up steps for a distance of approximately 44 metres in a generally east-north-easterly direction to a junction with public footpath BC54/39. The footpath continues for a distance of approximately 8 metres to where the direction changes to generally easterly. The footpath continues for a distance of approximately 8 metres to where the steps end. The footpath continues for a distance of approximately 107 metres to where the direction changes to generally south-easterly at its junction with public footpath BC64/2. The footpath continues for a distance of approximately 357 metres to where the direction changes to generally south-westerly at the junction with public footpath BC64/6. The footpath continues for a distance of approximately 4 metres to a kissing gate. The footpath continues for a distance of approximately 189 metres to where the direction changes to generally southerly. The footpath continues for a distance of approximately 8 metres to where steps start. The footpath continues for a distance of approximately 51 metres to where the steps end at a kissing gate. The footpath continues for a distance of approximately 93 metres to where it finishes on footpath CQ42.

Path Number: BC54/40 (continued)

Conclusive Evidential Provisions	
Conditions and Limitations	Position
The right of the landowner to erect and maintain: Kissing Gate Kissing Gate	ST 7632 6447 ST 7620 6426

PART II
Modification of Definitive Statement
Variation of particulars of path or way

A new Statement shall be recorded for BC63/2 as follows:

Path Number: BC63/2

Status: Footpath
Length: Approximately 448 metres
Ward / Parish: Bathwick
Width: 1.8 metres between Grid References ST 7678 6377 and ST 7722 6369, narrowing to 1.25 metres at the stone stile at Grid Reference ST 7720 6370, as shown on the map numbered Part 3 included in the Bath and North East Somerset Council (City of Bath Definitive Map and Statement Modification Order) (No.11 – Bathwick & Combe Down) 2015.

Description of Route			
From		General Direction	
County Road or Right of Way	Grid Reference	County Road or Right of Way	Grid Reference
Restricted Byway BC62/1	ST 7678 6377	SE	Public Footpath BC73/2
			ST 7722 6369

General Description:

The footpath starts on restricted byway BC62/1 and continues for a distance of approximately 431 metres in a generally south-easterly direction to a stone stile. The footpath continues for a distance of approximately 17 metres to where it finishes on public footpath BC73/2.

Conclusive Evidential Provisions	
Conditions and Limitations	Position
The right of the landowner to erect and maintain: Stone Stile	ST 7720 6370

PART II
Modification of Definitive Statement
Variation of particulars of path or way

A new Statement shall be recorded for BC64/1 as follows:

Path Number: BC64/1

Status: Footpath
Length: Approximately ¹⁵³151 metres
Ward / Parish: Bathwick
Width: 1.8 metres

between Grid References ST 7648 6488 and ST 7659 6486, narrowing to 0.8 metres at the Kissing Gate at Grid Reference ST 7653 6490, as shown on the map numbered Part 4 included in the Bath and North East Somerset Council (City of Bath Definitive Map and Statement Modification Order) (No.11 – Bathwick & Combe Down) 2015.

Description of Route			
From		General Direction	To
County Road or Right of Way	Grid Reference		County Road or Right of Way Grid Reference
Public Footpath AQ36	ST 7648 6488	SE	Public Footpath BA1/20 ST 7659 6486

General Description:

The footpath starts on public footpath AQ36 and continues for a distance of approximately 53 metres in a generally north-easterly direction to a kissing gate, where the direction changes to generally easterly. The footpath continues for a distance of approximately 2 metres to where it meets the Golf Course Road. The footpath continues for a distance of approximately 4 metres across the Golf Course Road. The footpath continues for a distance of approximately 42 metres to where the direction changes to generally southerly. The footpath continues for a distance of approximately 17 metres to where it changes direction to generally south-easterly. The footpath continues for a distance of approximately 8 metres to where it changes direction to generally southerly. The footpath continues for a distance of approximately 6 metres to where it changes direction to generally south-easterly. The footpath continues for a distance of approximately 19 metres to where it finishes on public footpath BA1/20.

Path Number: BC64/1 (continued)

Conclusive Evidential Provisions	
Conditions and Limitations	Position
The right of the landowner to erect and maintain: Kissing Gate	ST 7653 6490

PART II
Modification of Definitive Statement
Variation of particulars of path or way

A new Statement shall be recorded for BC64/2 as follows:

Path Number: BC64/2

Status: Footpath
Length: Approximately 43 metres
Ward / Parish: Bathwick
Width: Varies between 2.3 metres – 8.4 metres, as shown shaded grey on the map numbered Part 5 included in the Bath and North East Somerset Council (City of Bath Definitive Map and Statement Modification Order) (No.11 – Bathwick & Combe Down) 2015.

Description of Route			
From		General Direction	To
County Road or Right of Way	Grid Reference		County Road or Right of Way Grid Reference
Public Footpath BC54/40	ST 7601 6466	NE	Bathwick Hill ST 7604 6469

General Description:

The footpath starts on public footpath BC54/40 and continues for a distance of approximately 43 metres in a generally north-easterly direction to where it finishes on Bathwick Hill.

Conclusive Evidential Provisions	
Conditions and Limitations	Position
None	

PART II
Modification of Definitive Statement
Variation of particulars of path or way

A new Statement shall be recorded for BC64/3 as follows:

Path Number: BC64/3

Status: Footpath
Length: Approximately 264 metres
Ward / Parish: Bathwick
Width: Varies between 2.4 metres – 5.7 metres, as shown shaded grey on the map numbered Part 6 included in the Bath and North East Somerset Council (City of Bath Definitive Map and Statement Modification Order) (No.11 – Bathwick & Combe Down) 2015.

Description of Route			
From		General Direction	
County Road or Right of Way	Grid Reference	County Road or Right of Way	To Grid Reference
Public Footpath BA1/20	ST 7657 6466	SE North Road	ST 7671 6444

General Description:

The footpath starts on public footpath BA1/20 and continues for a distance of approximately 264 metres in a generally south-easterly direction to where it finishes on North Road.

Conclusive Evidential Provisions	
Conditions and Limitations	Position
None	

PART II
Modification of Definitive Statement
Variation of particulars of path or way

A new Statement shall be recorded for BC64/4 as follows:

Path Number: BC64/4

Status: Footpath
Length: Approximately 278 metres
Ward / Parish: Bathwick
Width: 1.8 metres between Grid References ST 7677 6447 and ST 7689 6468, as shown on the map numbered Part 7 included in the Bath and North East Somerset Council (City of Bath Definitive Map and Statement Modification Order) (No.11 – Bathwick & Combe Down) 2015.

Description of Route			
From		General Direction	
County Road or Right of Way	Grid Reference	County Road or Right of Way	Grid Reference
Public Bridleway BC74/4	ST 7677 6447	Public Bridleway BC74/4	ST 7689 6468

General Description:

The footpath starts on public bridleway BC74/4 and continues for a distance of approximately 31 metres in a generally north-westerly direction to where steps start and the direction changes to generally northerly. The footpath continues up the steps for a distance of approximately 19 metres to where the steps end. The footpath continues for a distance of approximately 34 metres to where the direction changes to generally north-easterly. The footpath continues for a distance of approximately 22 metres to where it is joined by public footpaths BA1/38, BA1/39 and BC64/5. The footpath continues for a distance of approximately 172 metres to where it finishes on public bridleway BC74/4.

Conclusive Evidential Provisions	
Conditions and Limitations	Position
None	

PART II
Modification of Definitive Statement
Variation of particulars of path or way

A new Statement shall be recorded for BC64/5 as follows:

Path Number: BC64/5

Status: Footpath
Length: Approximately 417 metres
Ward / Parish: Bathwick
Width: 1.8 metres between Grid References ST 7677 6456 and ST 7707 6429, as shown on the map numbered Part 8 included in the Bath and North East Somerset Council (City of Bath Definitive Map and Statement Modification Order) (No.11 – Bathwick & Combe Down) 2015.

From		Description of Route	
County Road or Right of Way	Grid Reference	General Direction	To
Public Footpaths BC64/4, BA1/38 and BA1/39	ST 7677 6456	SE	County Road or Right of Way Soldier Down Lane ST 7707 6429

General Description:

The footpath starts on public footpaths BC64/4, BA1/38 and BA1/39 and continues for a distance of approximately 4 metres in a generally south-easterly direction to where a footbridge starts. The footpath continues across the footbridge for a distance of approximately 22 metres to where it ends. The footpath continues for a distance of approximately 374 metres to where the direction changes to generally south-south-easterly. The footpath continues for a distance of approximately 17 metres to where it finishes on Soldier Down Lane.

Conclusive Evidential Provisions	
Conditions and Limitations	Position
None	

PART II
Modification of Definitive Statement
Variation of particulars of path or way

A new Statement shall be recorded for BC64/6 as follows:

Path Number: BC64/6

Status: Footpath
Length: Approximately 35 metres
Ward / Parish: Bathwick
Width: Varies between 1.8 metres – 3.0 metres, as shown shaded grey on the map numbered Part 9 included in the Bath and North East Somerset Council (City of Bath Definitive Map and Statement Modification Order) (No.11 – Bathwick & Combe Down) 2015.

Description of Route			
From		To	
County Road or Right of Way	Grid Reference	County Road or Right of Way	Grid Reference
Public Footpath BC54/40	ST 7632 6448	Bathwick Hill	ST 7633 6451

General Description:

The footpath starts on public footpath BC54/40 and continues for a distance of approximately 35 metres in a generally northerly direction to where it finishes on Bathwick Hill.

Conclusive Evidential Provisions	
Conditions and Limitations	Position
None	

PART II
Modification of Definitive Statement
Variation of particulars of path or way

A new Statement shall be recorded for BC65/5 as follows:

Path Number: BC65/5

Status: Footpath
Length: Approximately 27 metres
Ward / Parish: Bathwick
Width: Varies between 1.2 metres – 1.4 metres, as shown shaded grey on the map numbered Part 10 included in the Bath and North East Somerset Council (City of Bath Definitive Map and Statement Modification Order) (No.11 – Bathwick & Combe Down) 2015.

Description of Route			
From		General Direction	
County Road or Right of Way	Grid Reference	County Road or Right of Way	To Grid Reference
Warminster Road	ST 7642 6574	SE Minster Way	ST 7644 6572

General Description:

The footpath starts on Warminster Road and continues up steps for a distance of approximately 3 metres in a generally south-easterly direction to where the steps end. The footpath continues for a distance of approximately 24 metres to where it finishes on Minster Way.

Conclusive Evidential Provisions	
Conditions and Limitations	Position
None	

PART II
Modification of Definitive Statement
Variation of particulars of path or way

A new Statement shall be recorded for BC65/6 as follows:

Path Number: BC65/6

Status: Footpath
Length: Approximately 43 metres
Ward / Parish: Bathwick
Width: Varies between 1.1 metres – 1.3 metres, as shown shaded grey on the map numbered Part 11 included in the Bath and North East Somerset Council (City of Bath Definitive Map and Statement Modification Order) (No.11 – Bathwick & Combe Down) 2015.

Description of Route			
From		General Direction	
County Road or Right of Way	Grid Reference	To	
		County Road or Right of Way	Grid Reference
Warminster Road	ST 7608 6549	St Christopher's Close	ST 7612 6547

General Description:

The footpath starts on Warminster Road and continues for a distance of approximately 20 metres in a generally south-south-easterly direction to where the direction changes to generally east-south-easterly. The footpath continues for a distance of approximately 23 metres to where it finishes on St Christopher's Close.

Conclusive Evidential Provisions	
Conditions and Limitations	Position
None	

PART II
Modification of Definitive Statement
Variation of particulars of path or way

A new Statement shall be recorded for BC65/7 as follows:

Path Number: BC65/7

Status: Footpath
Length: Approximately 121 metres
Ward / Parish: Bathwick
Width: Varies between 1.3 metres – 4.1 metres, as shown shaded grey on the map numbered Part 12 included in the Bath and North East Somerset Council (City of Bath Definitive Map and Statement Modification Order) (No.11 – Bathwick & Combe Down) 2015.

Description of Route			
From		General Direction	
County Road or Right of Way	Grid Reference	To	
		County Road or Right of Way	Grid Reference
Cleveland Walk	ST 7624 6504	N North Road	ST 7636 6502

General Description:

The footpath starts on Cleveland Walk and continues for a distance of approximately 118 metres in a generally east-south-easterly direction to where steps start. The footpath continues up steps for a distance of approximately 3 metres to where it finishes on North Road.

Conclusive Evidential Provisions	
Conditions and Limitations	Position
None	

PART II
Modification of Definitive Statement
Variation of particulars of path or way

A new Statement shall be recorded for BC72/1 as follows:

Path Number: BC72/1

Status: Footpath
Length: Approximately 320 metres
Ward / Parish: Combe Down
Width: 1.8 metres between Grid References ST 7766 6294 and ST 7789 6281, narrowing to 0.9 metres at the Kissing Gate at Grid Reference ST 7783 6283 and 0.6 metres at the Kissing Gate at Grid Reference ST 7789 6281. Between Grid References ST 7789 6281 and ST 7793 6278, varies between 0.6 metres – 1.6 metres, as shown shaded grey on the map numbered Part 13 included in the Bath and North East Somerset Council (City of Bath Definitive Map and Statement Modification Order) (No.11 – Bathwick & Combe Down) 2015.

Description of Route			
From		To	
County Road or Right of Way	Grid Reference	County Road or Right of Way	Grid Reference
Public Footpath AQ96c	ST 7766 6294	Brassknocker Hill	ST 7793 6278
		SE	

General Description:

The footpath starts on public footpath AQ96c and continues across a pasture field for a distance of approximately 203 metres in a generally south-easterly direction to a kissing gate. The footpath continues for a distance of approximately 58 metres to where it changes direction to generally north-easterly. The footpath continues for a distance of approximately 4 metres to a kissing gate where the direction changes to generally south-easterly. The footpath continues for a distance of approximately 55 metres to where it finishes at steps on Brassknocker Hill.

Path Number: BC72/1 (continued)

Conclusive Evidential Provisions	
Conditions and Limitations	Position
The right of the landowner to erect and maintain: Kissing Gate Kissing Gate	 ST 7783 6283 ST 7789 6281

PART II
Modification of Definitive Statement
Variation of particulars of path or way

A new Statement shall be recorded for BC73/2 as follows:

Path Number: BC73/2

Status: Footpath
Length: Approximately 1216 metres
Ward / Parish: Bathwick & Combe Down
Width: 1.8 metres between Grid References ST 7717 6398 and ST 7753 6342, narrowing to 1.2 metres at Grid Reference ST 7717 6398, 1.4 metres at Grid Reference ST 7722 6369, 1.2 metres at Grid Reference ST 7723 6368, 1.2 metres at Grid Reference ST 7741 6353, 1.2 metres at Grid Reference ST 7753 6342, 3 metres between Grid References ST 7753 6342 and ST 7762 6296, narrowing to 1.2 metres at Grid Reference ST 7762 6296, as shown on the map numbered Part 14 included in the Bath and North East Somerset Council (City of Bath Definitive Map and Statement Modification Order) (No.11 – Bathwick & Combe Down) 2015.

Description of Route			
From		To	
County Road or Right of Way	Grid Reference	County Road or Right of Way	Grid Reference
Claverton Down Road	ST 7717 6398	Claverton Down Road	ST 7762 6296

General Description:

The footpath starts at a pedestrian gate on Claverton Down Road and continues for a distance of approximately 291 metres in a generally southerly direction to where it is joined by public footpath BC63/2. The footpath continues for a distance of approximately 7 metres to a stone stile where the direction changes to generally south-easterly. The footpath continues for a distance of approximately 14 metres to a field boundary. The footpath continues for a distance of approximately 158 metres to a pedestrian gate where the direction changes to generally southerly. The footpath continues for a distance of approximately 278 metres to where the direction changes to generally

Path Number: BC73/2 (continued)

south-south-easterly. The footpath continues for a distance of approximately 228 metres to where it finishes at a stone stile on Claverton Down Road.

Conclusive Evidential Provisions	
Conditions and Limitations	Position
The right of the landowner to erect and maintain:	
Pedestrian Gate	ST 7717 6398
Stone Stile	ST 7722 6369
Pedestrian Gate	ST 7753 6342
Stone Stile	ST 7762 6296

PART II
Modification of Definitive Statement
Variation of particulars of path or way

A new Statement shall be recorded for BC73/3 as follows:

Path Number: BC73/3

Status: Bridleway
Length: Approximately 471 metres
Ward / Parish: Bathwick
Width: Varies between 2.9 metres – 8.2 metres, as shown shaded grey on the map numbered Part 15 included in the Bath and North East Somerset Council (City of Bath Definitive Map and Statement Modification Order) (No.11 – Bathwick & Combe Down) 2015.

Description of Route			
From		General Direction	
County Road or Right of Way	Grid Reference	To	
		County Road or Right of Way	Grid Reference
Claverton Down Road	ST 7792 6360	N Claverton Hill	ST 7804 6403

General Description:

The bridleway starts on Claverton Down Road and continues for a distance of approximately 471 metres in a generally northerly direction to where it finishes on Claverton Hill.

Conclusive Evidential Provisions	
Conditions and Limitations	Position
None	

PART II
Modification of Definitive Statement
Variation of particulars of path or way

A new Statement shall be recorded for BC74/2 as follows:

Path Number: BC74/2

Status: Footpath
Length: Approximately 199 metres
Ward / Parish: Bathwick
Width: 1.8 metres between Grid References ST 7758 6447 and ST 7745 6458, as shown on the map numbered Part 16 included in the Bath and North East Somerset Council (City of Bath Definitive Map and Statement Modification Order) (No.11 – Bathwick & Combe Down) 2015.

Description of Route			
From		General Direction	
County Road or Right of Way	Grid Reference	County Road or Right of Way	To Grid Reference
Public Footpath AQ210	ST 7758 6447	NE Public Bridleway BC74/1	ST 7745 6458

General Description:

The footpath starts on public footpath AQ210 and continues for a distance of approximately 181 metres in a generally north-easterly direction to where the direction changes to generally northerly. The footpath continues for a distance of approximately 18 metres to where it finishes on Public Bridleway BC74/1.

Conclusive Evidential Provisions	
Conditions and Limitations	Position
None	

PART II
Modification of Definitive Statement
Variation of particulars of path or way

A new Statement shall be recorded for BC74/5 as follows:

Path Number: BC74/5

Status: Footpath
Length: Approximately 360 metres
Ward / Parish: Bathwick
Width: 1.8 metres between Grid References ST 7774 6377 and ST 7781 6408, narrowing to 1.2 metres at the gap at Grid Reference ST 7781 6408. Varies between 1.1 metres – 1.8 metres, as shown shaded grey on the map numbered Part 17 included in the Bath and North East Somerset Council (City of Bath Definitive Map and Statement Modification Order) (No.11 – Bathwick & Combe Down) 2015.

Description of Route			
From		General Direction	To
County Road or Right of Way	Grid Reference		County Road or Right of Way Grid Reference
Claverton Down Road	ST 7773 6373	N	The Avenue ST 7781 6408

General Description:

The footpath starts on Claverton Down Road and continues for a distance of approximately 360 metres in a generally northerly direction to where it finishes on The Avenue.

Conclusive Evidential Provisions	
Conditions and Limitations	Position
None	

PART II
Modification of Definitive Statement
Variation of particulars of path or way

The Statement for BC62/1 shall be amended to read as follows:

Modification of Definitive Statement

Path Number: **BC62/1**

Status: Footpath
Length: Approximately 1418m
Ward / Parish: Bathwick and Widcombe
Width: Between ST 7657 6272 and ST 7682 6381, 1.8m. Between ST 7682 6381 and ST 7692 6403, the width varies, as shown shaded on the Order Plan included in the Order: Bath and North East Somerset Council (Public Footpath AQ78 at Claverton Down, Bath Definitive Map and Statement Modification Order (No.1 – Claverton Down) 2006, generally 3.8 to 6 metres; up to 7 metres.

Description of Route			
From		General Direction	
County Road or Right of Way	Grid Reference	County Road or Right of Way	To Grid Reference
Claverton Down Road	ST 7657 6272	NNE	Widcombe Hill ST 7692 6403

General Description:

The footpath starts at a gate on Claverton Down Road, opposite the junction with Shaft Road. It continues in a north-north easterly direction for a distance of approximately 200 metres to a gate. It then crosses the eastern edge of Monument Field, reaching a kissing gate after a distance of approximately 341 metres. The footpath continues through woodland and then follows the western edge of the field for a distance of approximately 370 metres to a gap in the wall, restricted by a wooden post. The footpath takes a northerly direction for a distance of approximately 164 metres to the junction with public footpath BC63/2. The footpath continues for a distance of approximately 11 metres. It continues in a north-easterly direction for a distance of approximately 47 metres. The footpath then continues in an overall north easterly direction for a distance of approximately 285 metres to where it ends on Widcombe Hill, opposite the entrance to Copseland.

Path Number: BC62/1 (continued)

Conclusive Evidential Provisions	
Conditions and Limitations	Position
Gate	ST 7657 6272
Gate	ST 7662 6292
Kissing Gate	ST 7670 6325
Wooden Post	ST 7680 6361

PART II
Modification of Definitive Statement
Variation of particulars of path or way

The Statement for BC73/1 shall be amended to read as follows:

Modification of Definitive Statement

Path Number: **BC73/1**
Status: Footpath
Length: Approximately 406 metres
Ward / Parish: Bathwick
Width: Approximately 1.8 metres

Description of Route			
From		General Direction	To
County Road or Right of Way	Grid Reference		County Road or Right of Way
2 Bramley Cottages, Claverton Down Road.	ST 7777 6370	S & SW	Footpath BC73/2 south of Rainbow Wood Farm
			ST 7753 6343

General Description:

From start point and follows field edges to where it ends at the junction with public footpath BC73/2.

Conclusive Evidential Provisions	
Conditions and Limitations	Position
None	

PART II
Modification of Definitive Statement
Variation of particulars of path or way

The Statement for BC74/1 shall be amended to read as follows:

Modification of Definitive Statement

Path Number: BC74/1

Status: Bridleway
Length: Approximately 883m
Ward / Parish: Bathwick Ward
Width:

Description of Route			
From		To	
County Road or Right of Way	Grid Ref:	County Road or Right of Way	Grid Ref:
The Avenue	ST 7755 6414	Public Footpath BC74/2 & Bridleway BC74/3	ST 7774 6458
		N	

General Description:

From The Avenue running in a generally easterly direction for a distance of approximately 430 metres to ST 7788 6410 and then turning north veering north-west through ST 7790 6432 along the edge of a playing field for a distance of approximately 530 metres before finishing at the junction with public footpath BC74/2 and bridleway BC74/3.

Conclusive Evidential Provisions	
Conditions and Limitations	Position
None	

PART II
Modification of Definitive Statement
Variation of particulars of path or way

The Statement for BC74/3 shall be amended to read as follows:

Modification of Definitive Statement

Path Number: BC74/3

Status: Bridleway
Length: Approximately 313 metres
Ward / Parish: Bathwick
Width:

Description of Route			
From		General Direction	To
County Road or Right of Way	Grid Reference		County Road or Right of Way
Bridleway BC74/1 & Public Footpath BC74/2	ST 7774 6458	NNW	Bridleway BA1/31
			ST 7758 6484

General Description:

A new highway which shall be a bridleway, starting at the junction with bridleway BC74/1 & public footpath BC74/2 and continuing in a generally north-north-westerly direction for a distance of approximately 313 metres to where it ends on bridleway BA1/31.

Conclusive Evidential Provisions	
Conditions and Limitations	Position
None	

PART II
Modification of Definitive Statement
Variation of particulars of path or way

The Statement for BC74/4 shall be amended to read as follows:

Modification of Definitive Statement

Path Number: BC74/4

Status: Bridleway
Length: Approximately 560 metres
Ward / Parish: Bathwick
Width:

Description of Route			
From		General Direction	To
County Road or Right of Way	Grid Reference		County Road or Right of Way
North Road	ST 7675 6443	NE	Bridleway BA1/40
			ST 7710 6479

General Description:

A new highway which shall be a bridleway, starting on North Road and continuing in a generally north-easterly direction for a distance of approximately 43 metres to a junction with public footpath BC64/4. The bridleway continues for a distance of approximately 261 metres to a second junction with public footpath BC64/4. The bridleway continues for a distance of approximately 256 metres to where it finishes on bridleway BA1/40.

Conclusive Evidential Provisions	
Conditions and Limitations	Position
None	

Wildlife & Countryside Act 1981

Part 1

Bath & North East Somerset Council

Public Footpath BC54/39 at Bathwick Ward, Bath. City of Bath Definitive Map and Statement Modification Order (No.11 - Bathwick & Combe Down) 2015

Key

Footpath to be added to the Definitive Map and Statement.

A  **B**
ST 7589 6466 ST 7590 6469

The width of the footpath to be recorded is shown shaded and varies between 3.8m - 6.7m.


Other footpaths included in this Order

Unaffected other path

Order Map



Scale 1:1000

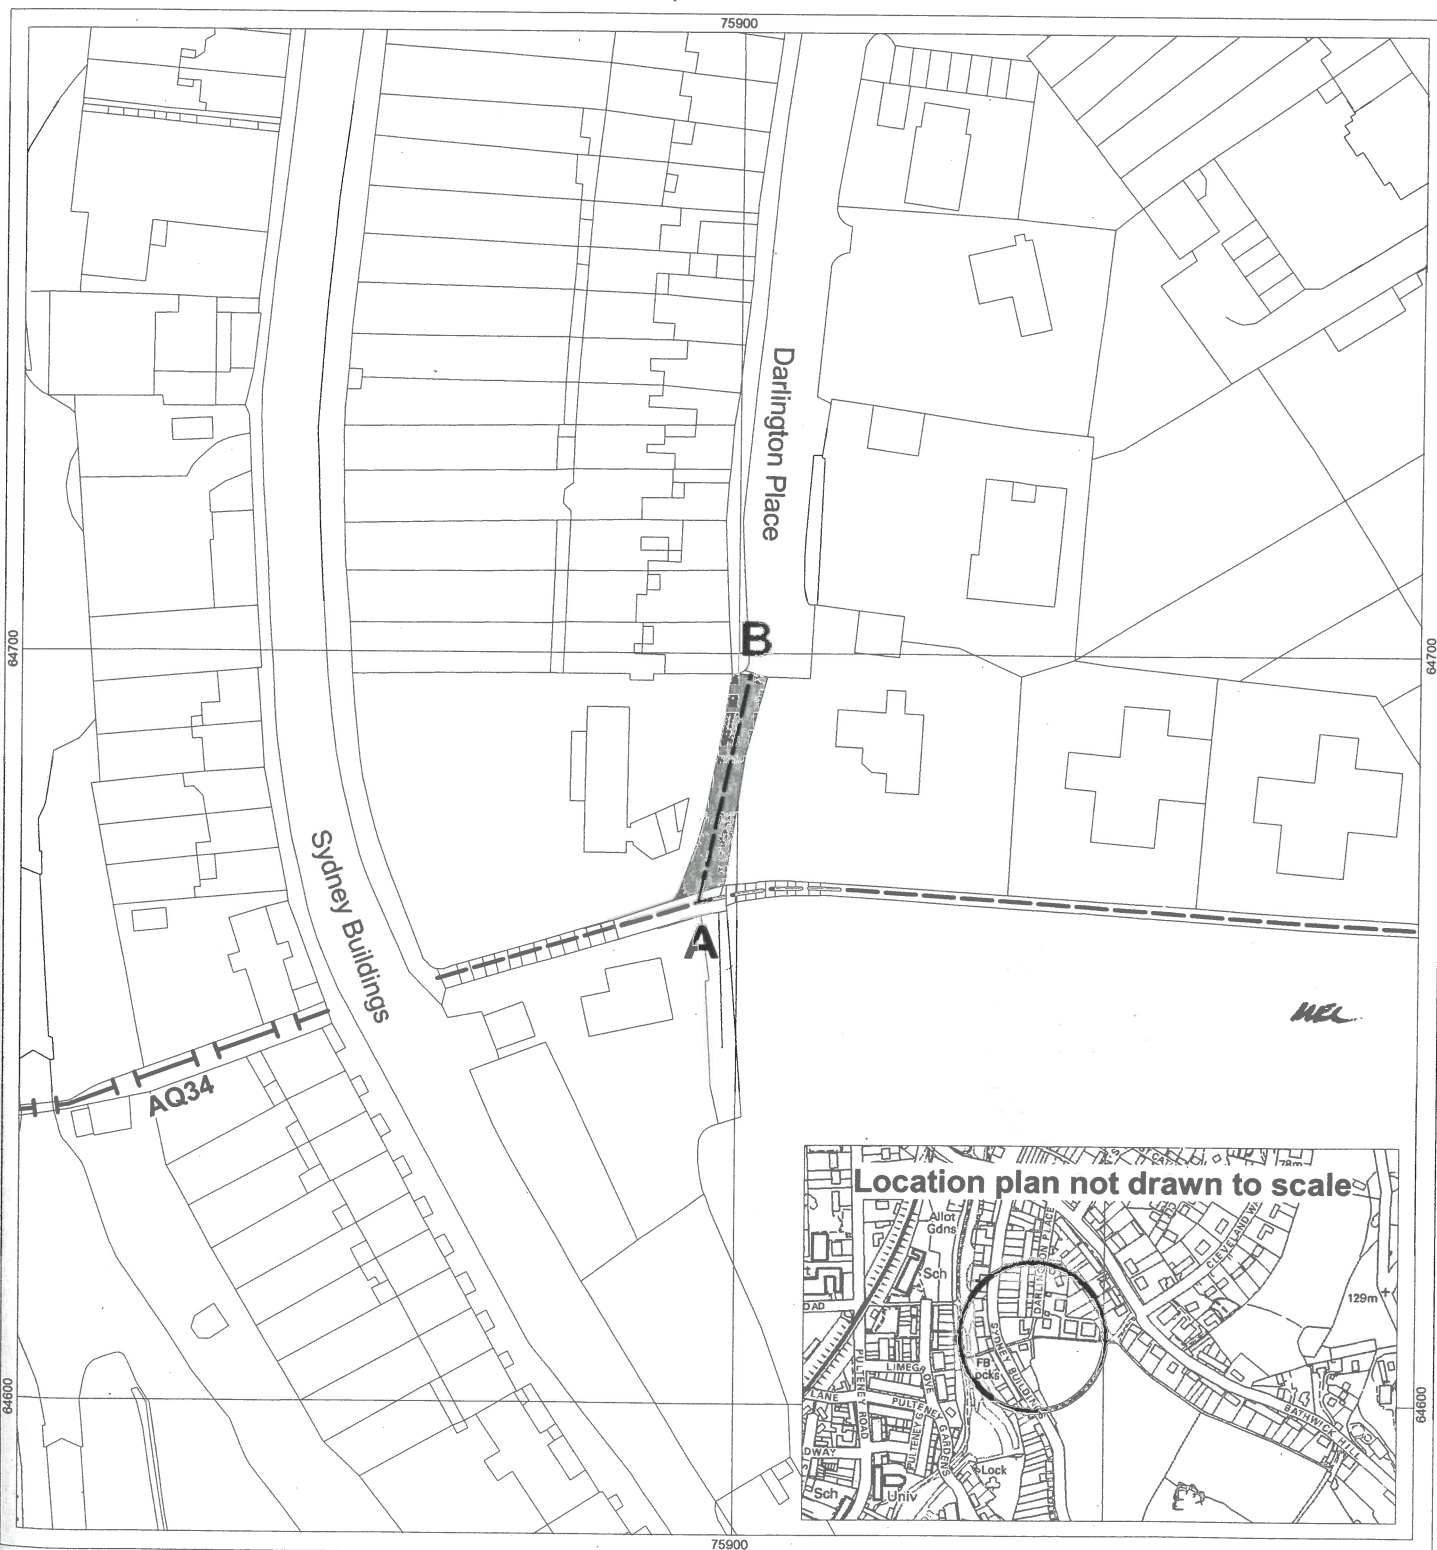

Wildlife & Countryside Act 1981

Part 2

Bath & North East Somerset Council Public Footpath BC54/40 at Bathwick Ward, Bath. City of Bath Definitive Map and Statement Modification Order (No.11 - Bathwick & Combe Down) 2015

Order Map





Scale 1:2500

Key Footpath to be added to the Definitive Map and Statement.

A B C D E F G H I J K L
ST 7586 6465 ST 7620 6417

The width of the footpath to be recorded is shown shaded and varies between 0.7m - 4.4m

- Other footpaths included in this Order
- Public footpath already legally recorded
- Unaffected other path

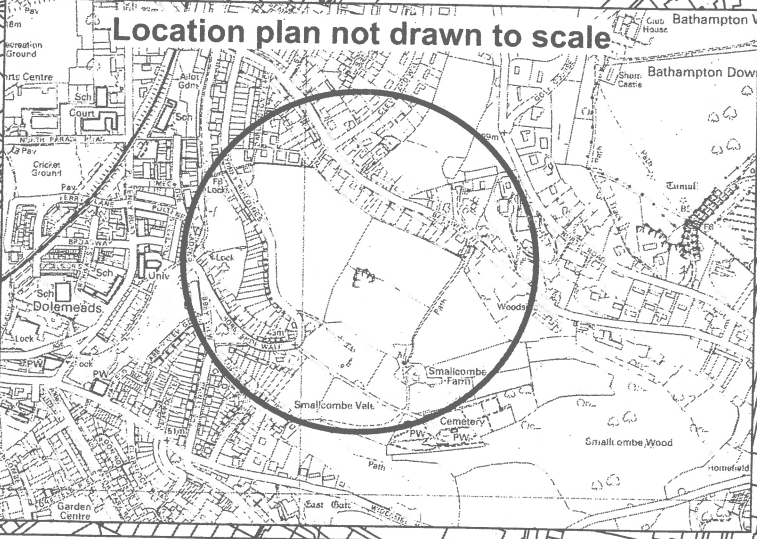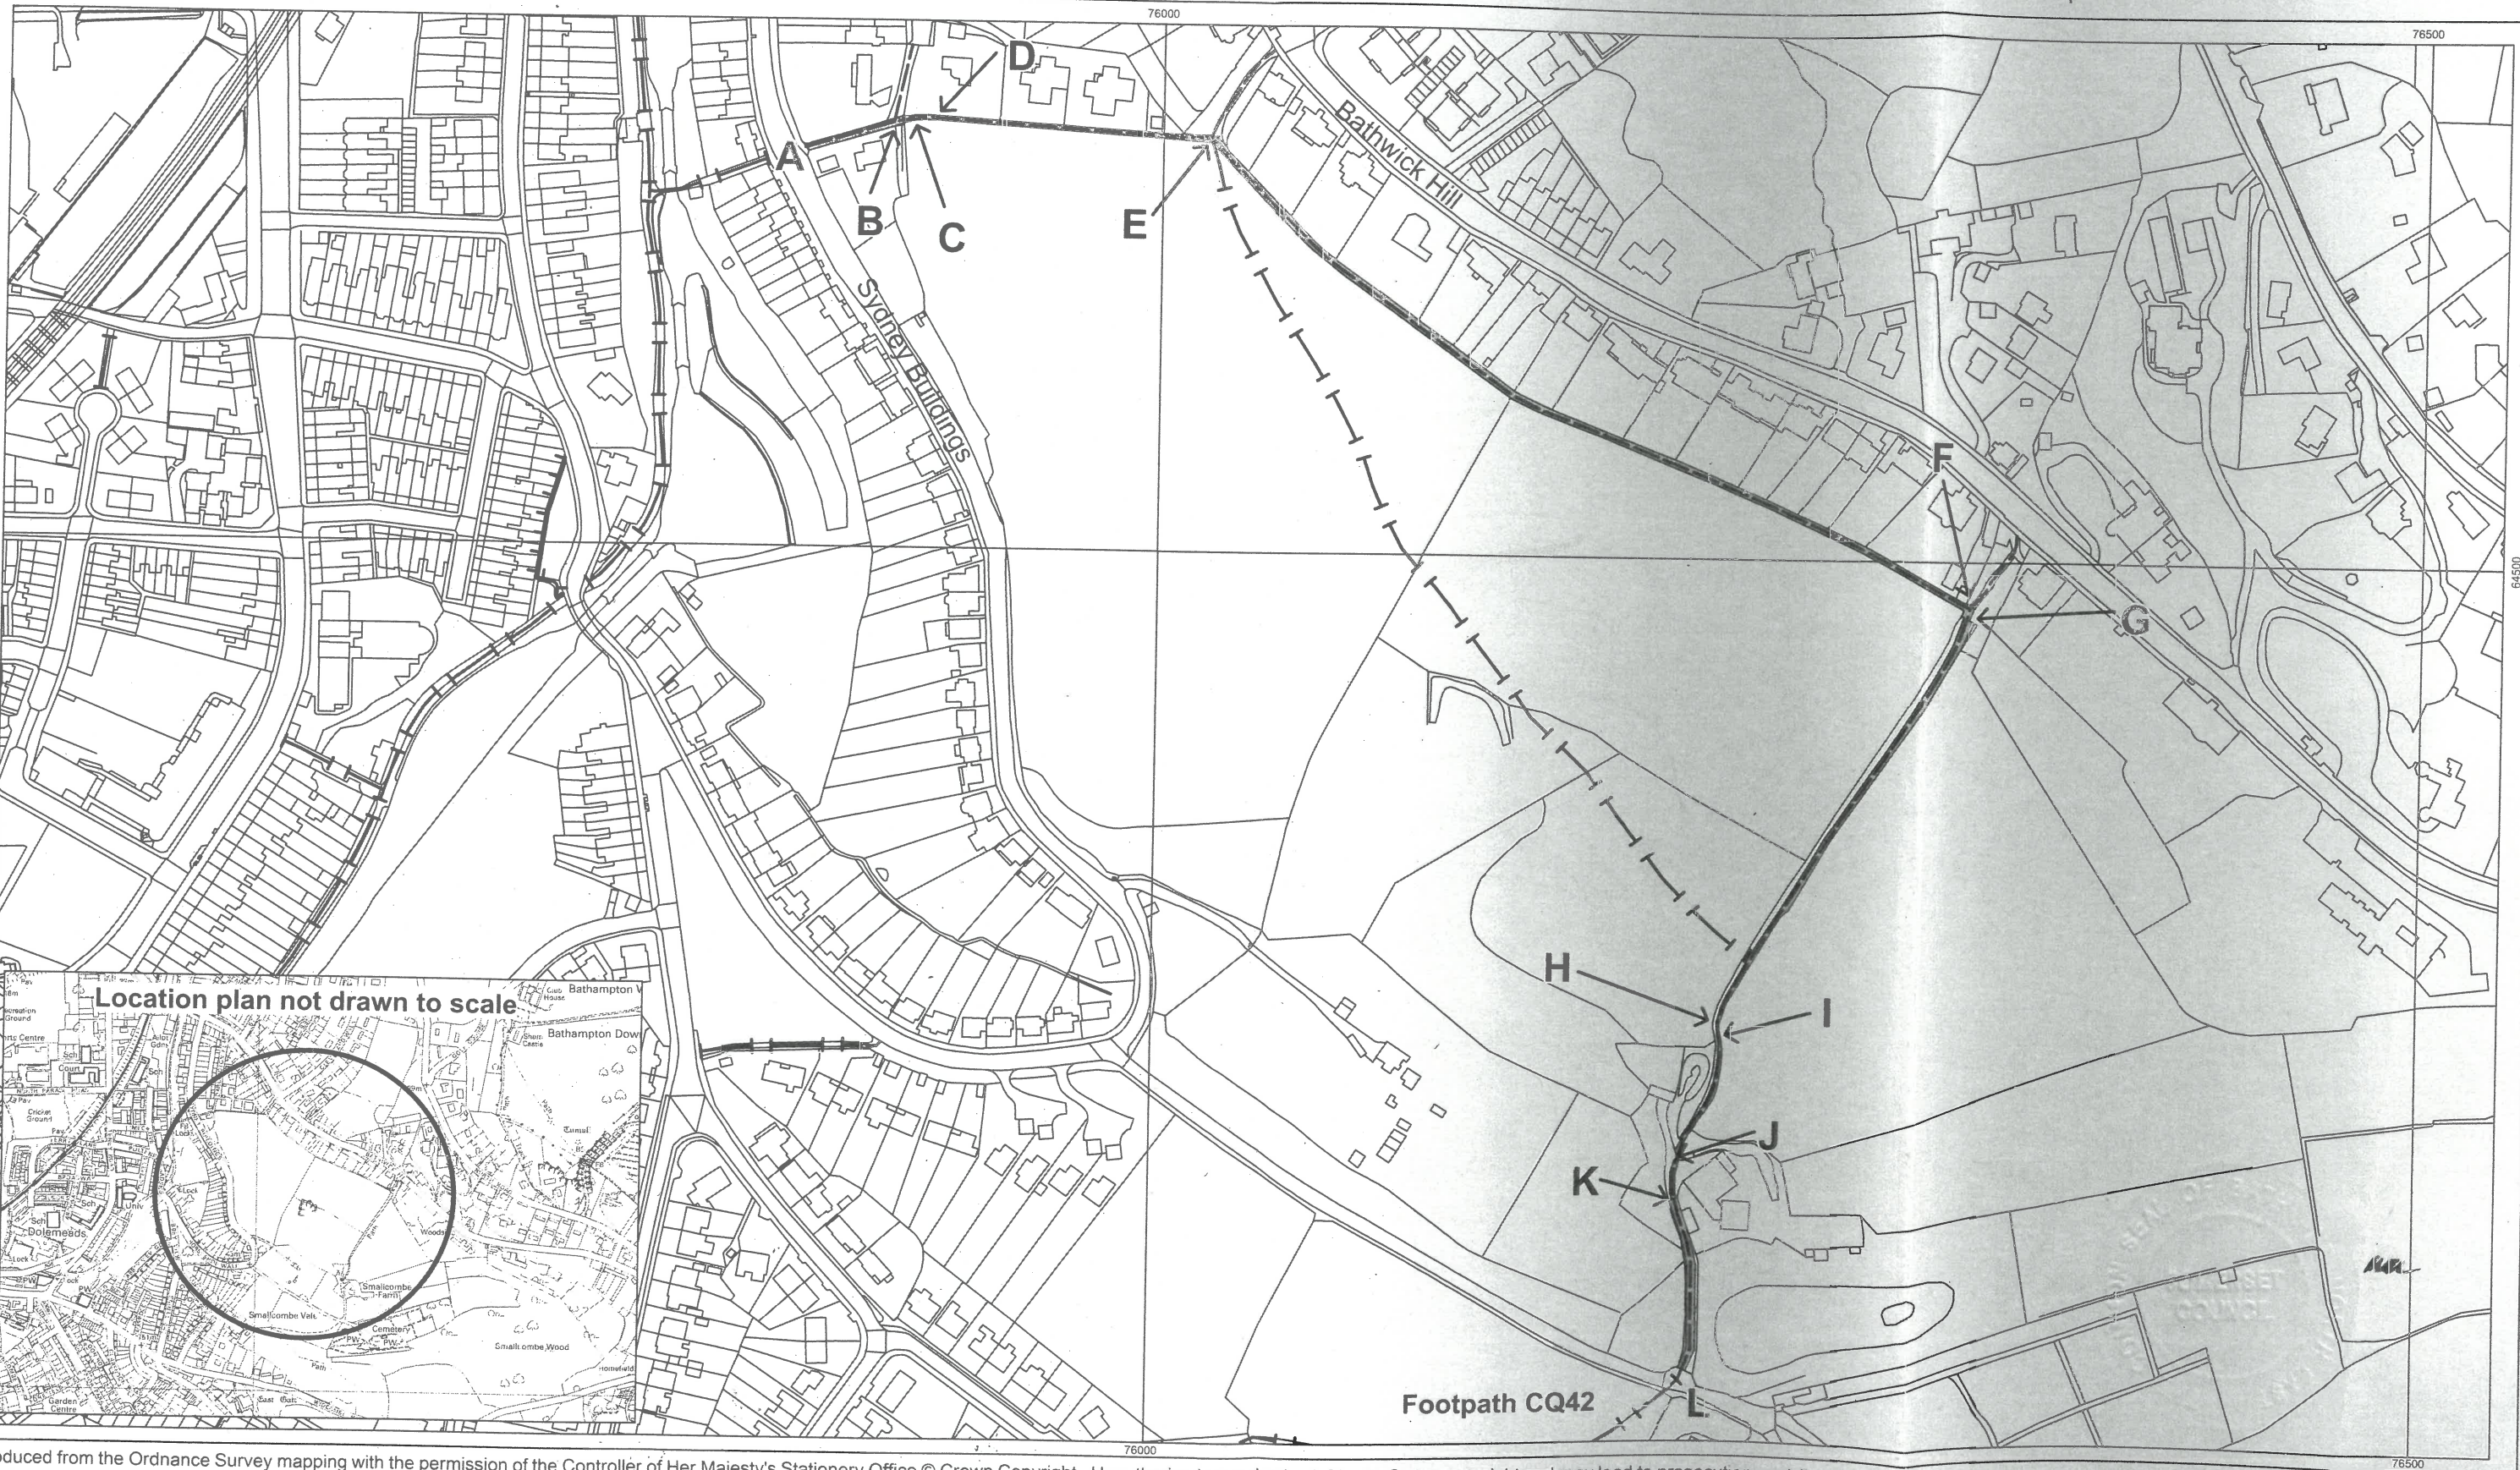

Footpath CQ42

Wildlife & Countryside Act 1981

Part 3

Bath & North East Somerset Council

Public Footpath BC63/2 at Bathwick Ward, Bath. City of Bath Definitive Map and Statement Modification Order (No.11 - Bathwick & Combe Down) 2015

Key

Footpath to be added to the Definitive Map and Statement.

A-----**B**-----**C** The width of the footpath to be recorded is 1.8m, narrowing to 1.25m at the stone stile at point B
ST 7678 6377 ST 7720 6370 ST 7722 6369


----- Other footpaths included in this Order

== Restricted Byway already legally recorded

Order Map



Scale 1:5000

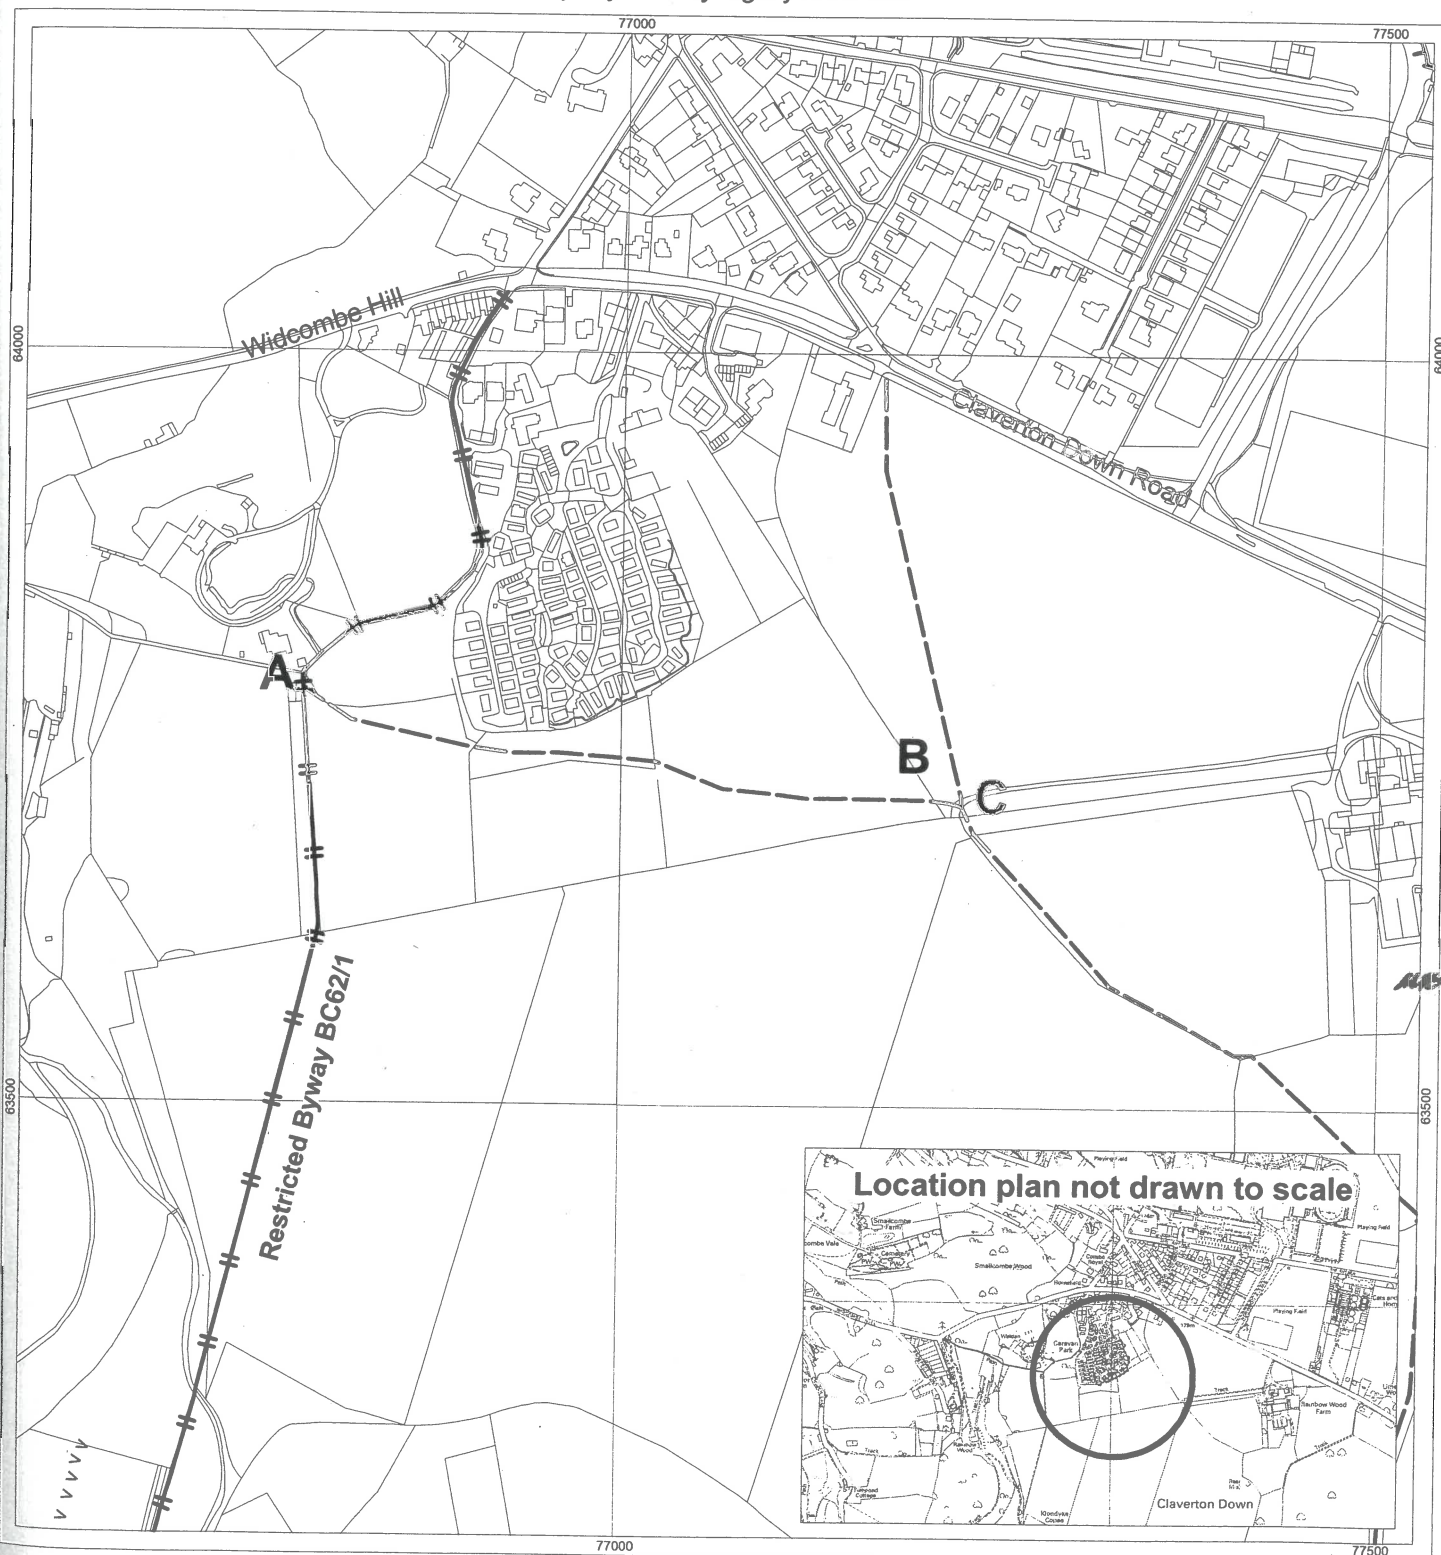

Location plan not drawn to scale

Wildlife & Countryside Act 1981

Part 4

Bath & North East Somerset Council

Public Footpath BC64/1 at Bathwick Ward, Bath. City of Bath Definitive Map and Statement Modification Order (No.11 - Bathwick & Combe Down) 2015

Key

Footpath to be added to the Definitive Map and Statement.

A-B-G-D-E-F-G-H-I
ST 7648 6488 ST 7659 6486

~~J-K-L-M~~
The width of the footpath to be recorded is 1.8m, narrowing to 0.8m at point B


Order Map



Scale 1:1500



Public footpath already legally recorded

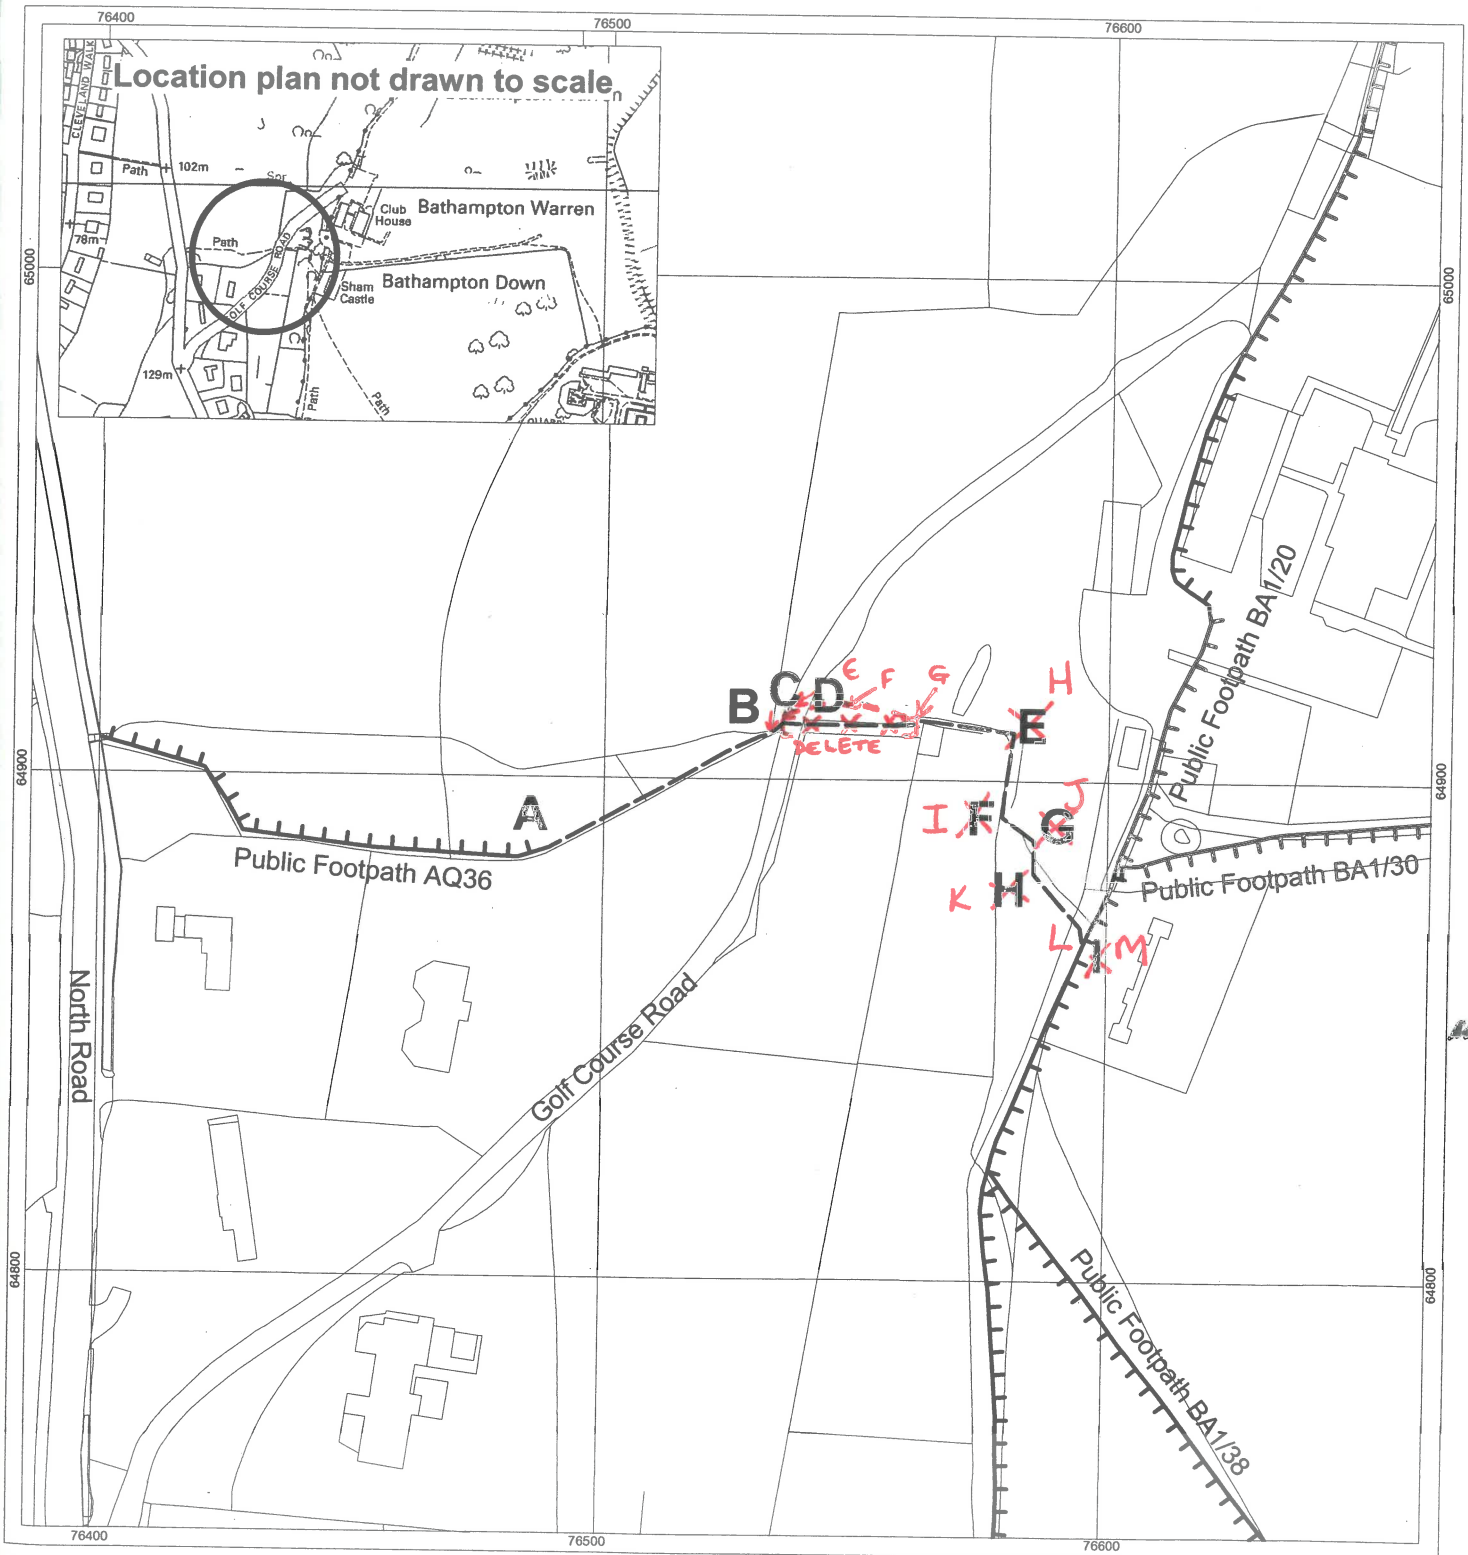

Wildlife & Countryside Act 1981

Part 5

Bath & North East Somerset Council

Public Footpath BC64/2 at Bathwick Ward, Bath. City of Bath Definitive Map and Statement Modification Order (No.11 - Bathwick & Combe Down) 2015

Key

Footpath to be added to the Definitive Map and Statement.

A  **B**
ST 7601 6466 ST 7604 6469

The width of the footpath to be recorded is shown shaded and varies between 2.3m - 8.4m.

Order Map




Scale 1:1000

Other footpaths included in this Order

|||||

Unaffected other path

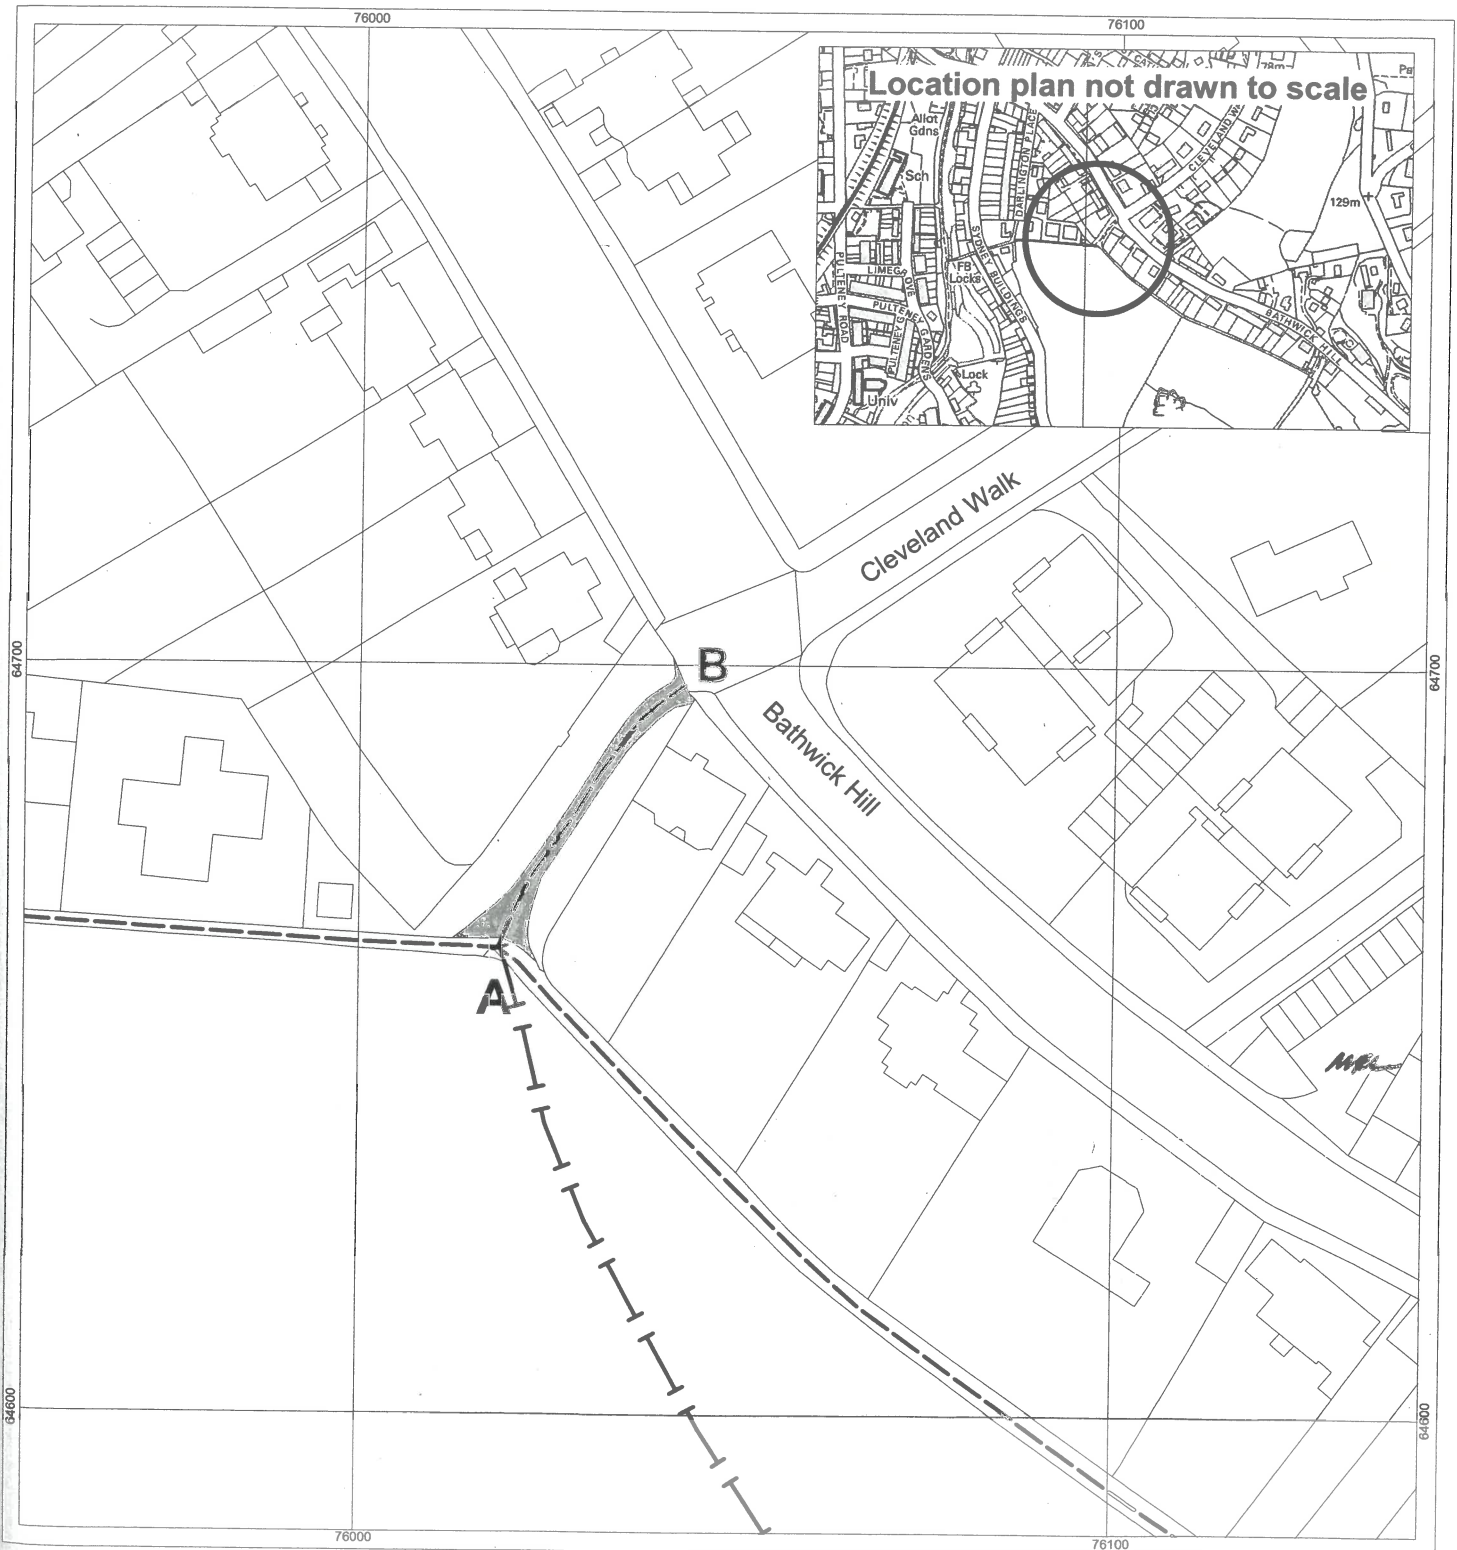

Wildlife & Countryside Act 1981 Part 6

Bath & North East Somerset Council

Public Footpath BC64/3 at Bathwick Ward, Bath. City of Bath Definitive Map and Statement Modification Order (No.11 - Bathwick & Combe Down) 2015

Key

Footpath to be added to the Definitive Map and Statement.

A  **B**
ST 7657 6466 ST 7671 6444

The width of the footpath to be recorded is shown shaded and varies between 2.4m - 5.7m.

Other footpaths included in this Order


Public footpath already legally recorded

Public bridleway already legally recorded

Order Map



Scale 1:2000

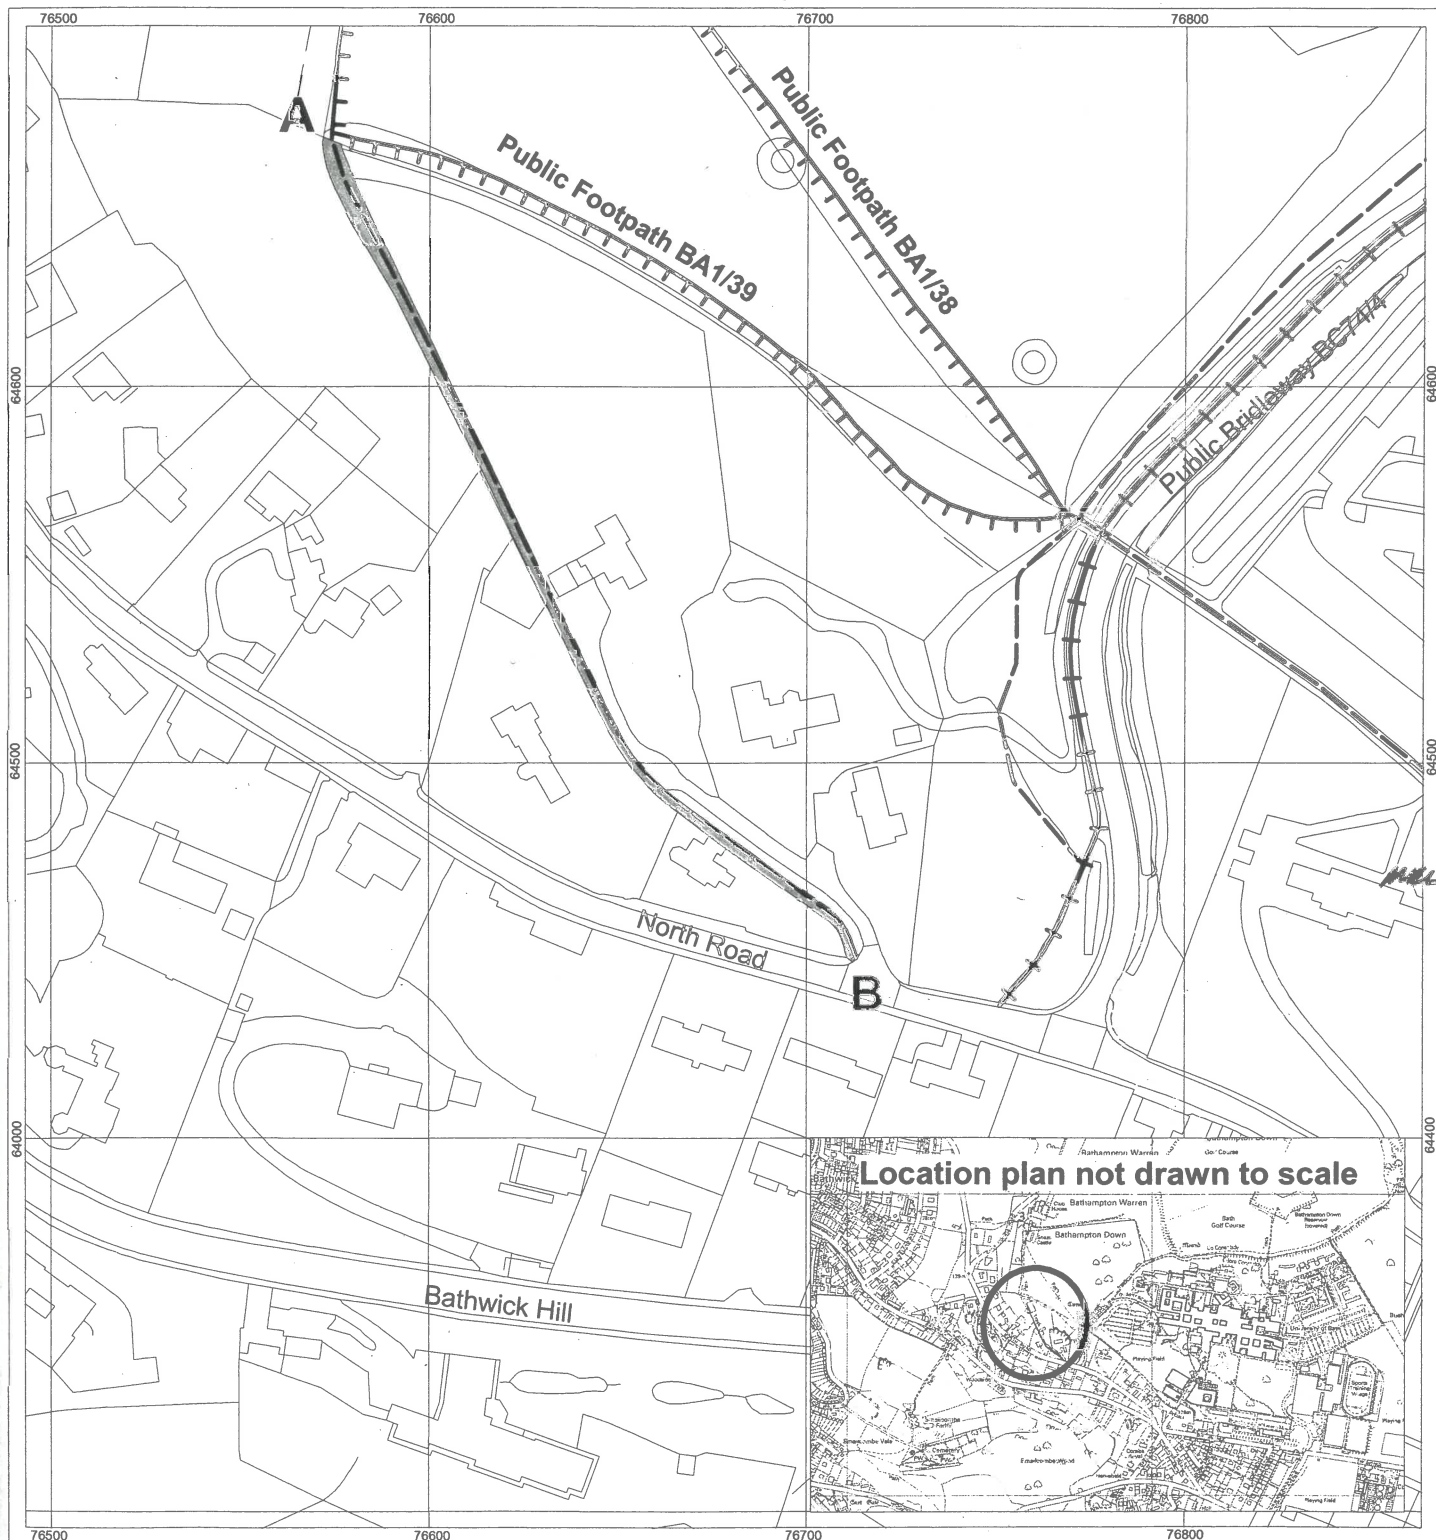

Public Footpath BC64/4 at Bathwick Ward, Bath. City of Bath Definitive Map and Statement Modification Order (No.11 - Bathwick & Combe Down) 2015

Footpath to be added to the Definitive Map and Statement.

A — B — C — D — E — F
ST 7677 6447 ST 7689 6468

The width of the footpath to be recorded is 1.8m.

Other footpaths included in this Order


Public footpath already legally recorded

Public bridleway already legally recorded

Order Map



Scale 1:1500

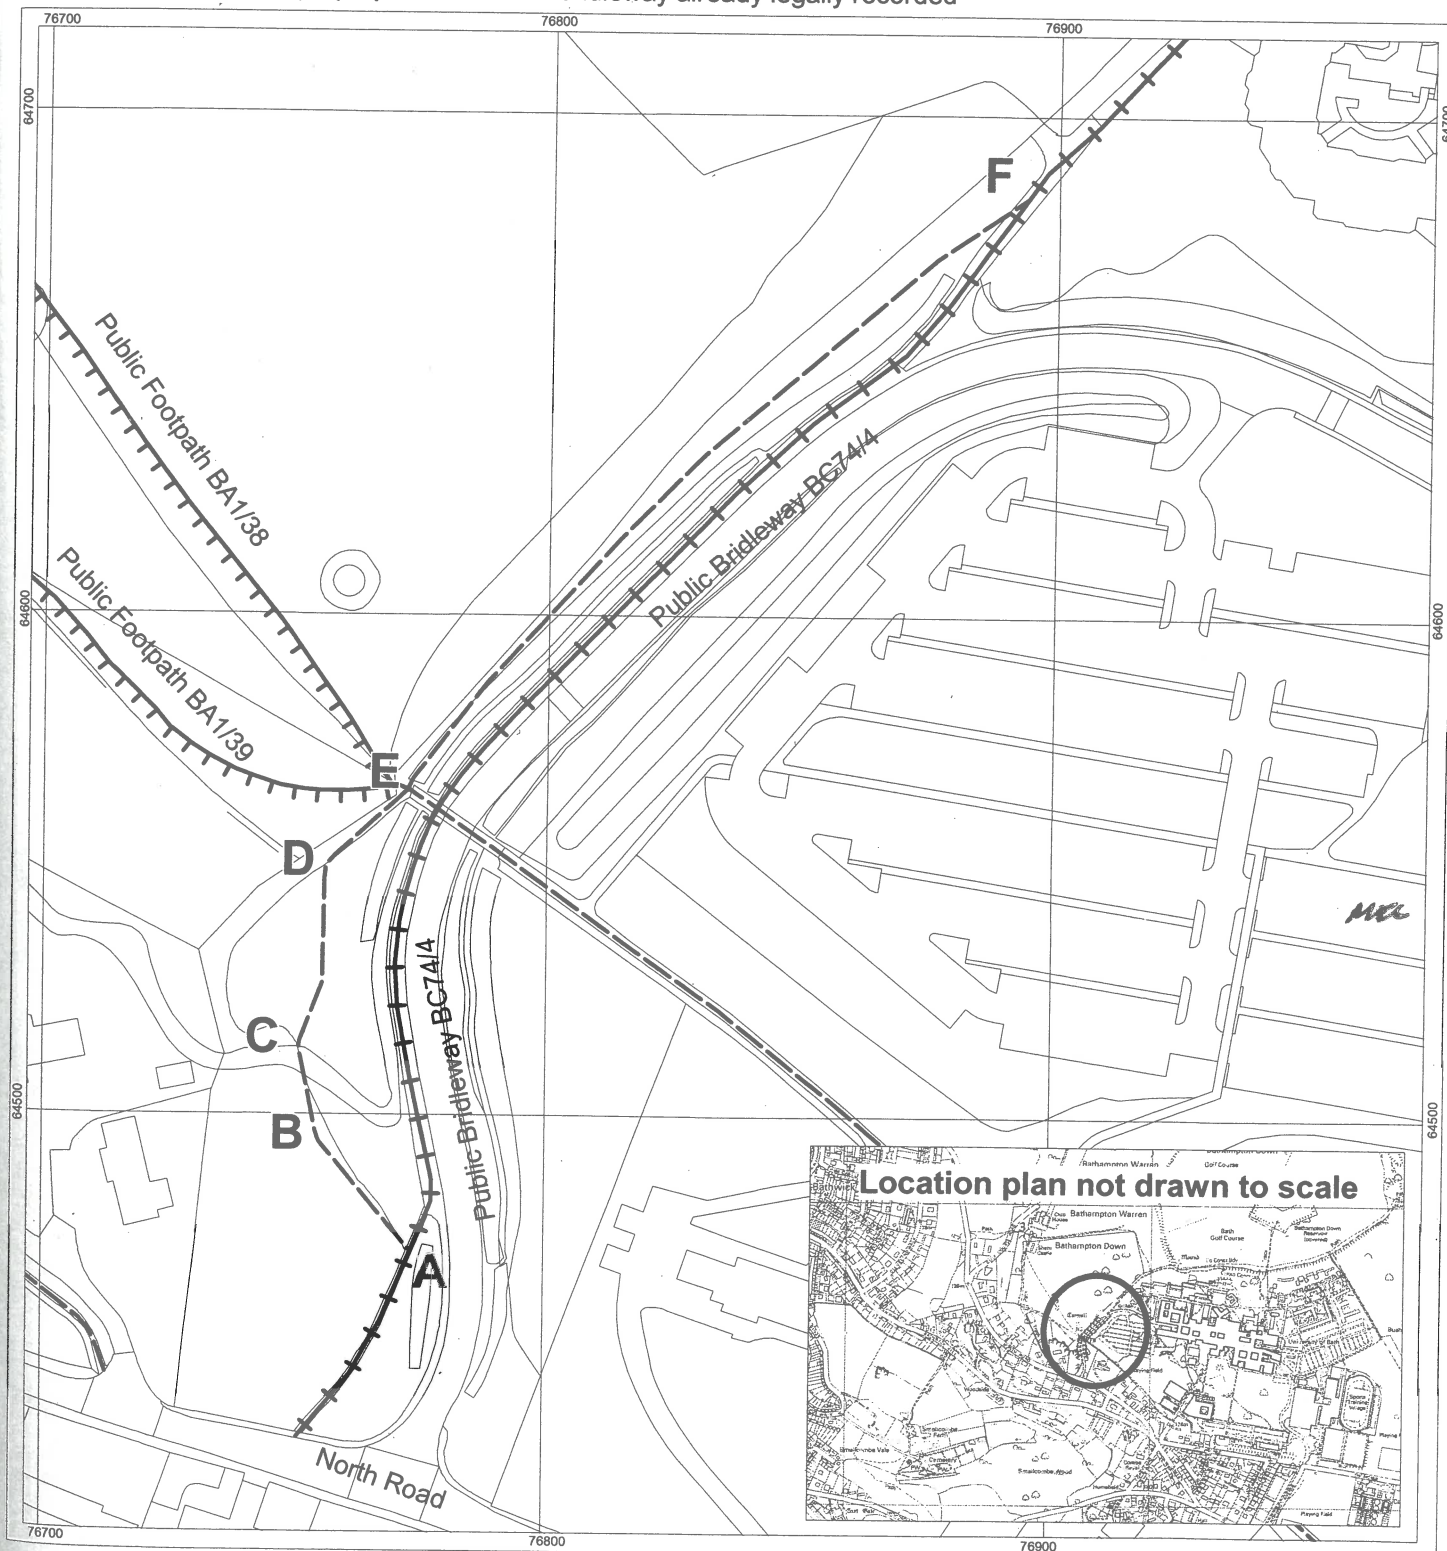

Wildlife & Countryside Act 1981

Part 8

Bath & North East Somerset Council

Public Footpath BC64/5 at Bathwick Ward, Bath. City of Bath Definitive Map and Statement Modification Order (No.11 - Bathwick & Combe Down) 2015

Key

Footpath to be added to the Definitive Map and Statement.

A **B** **C** **D** **E**
ST 7677 6456 ST 7707 6429

The width of the footpath to be recorded is 1.8m.

Order Map




Scale 1:2500




Other footpaths included in this Order

Public footpath already legally recorded

Public bridleway already legally recorded

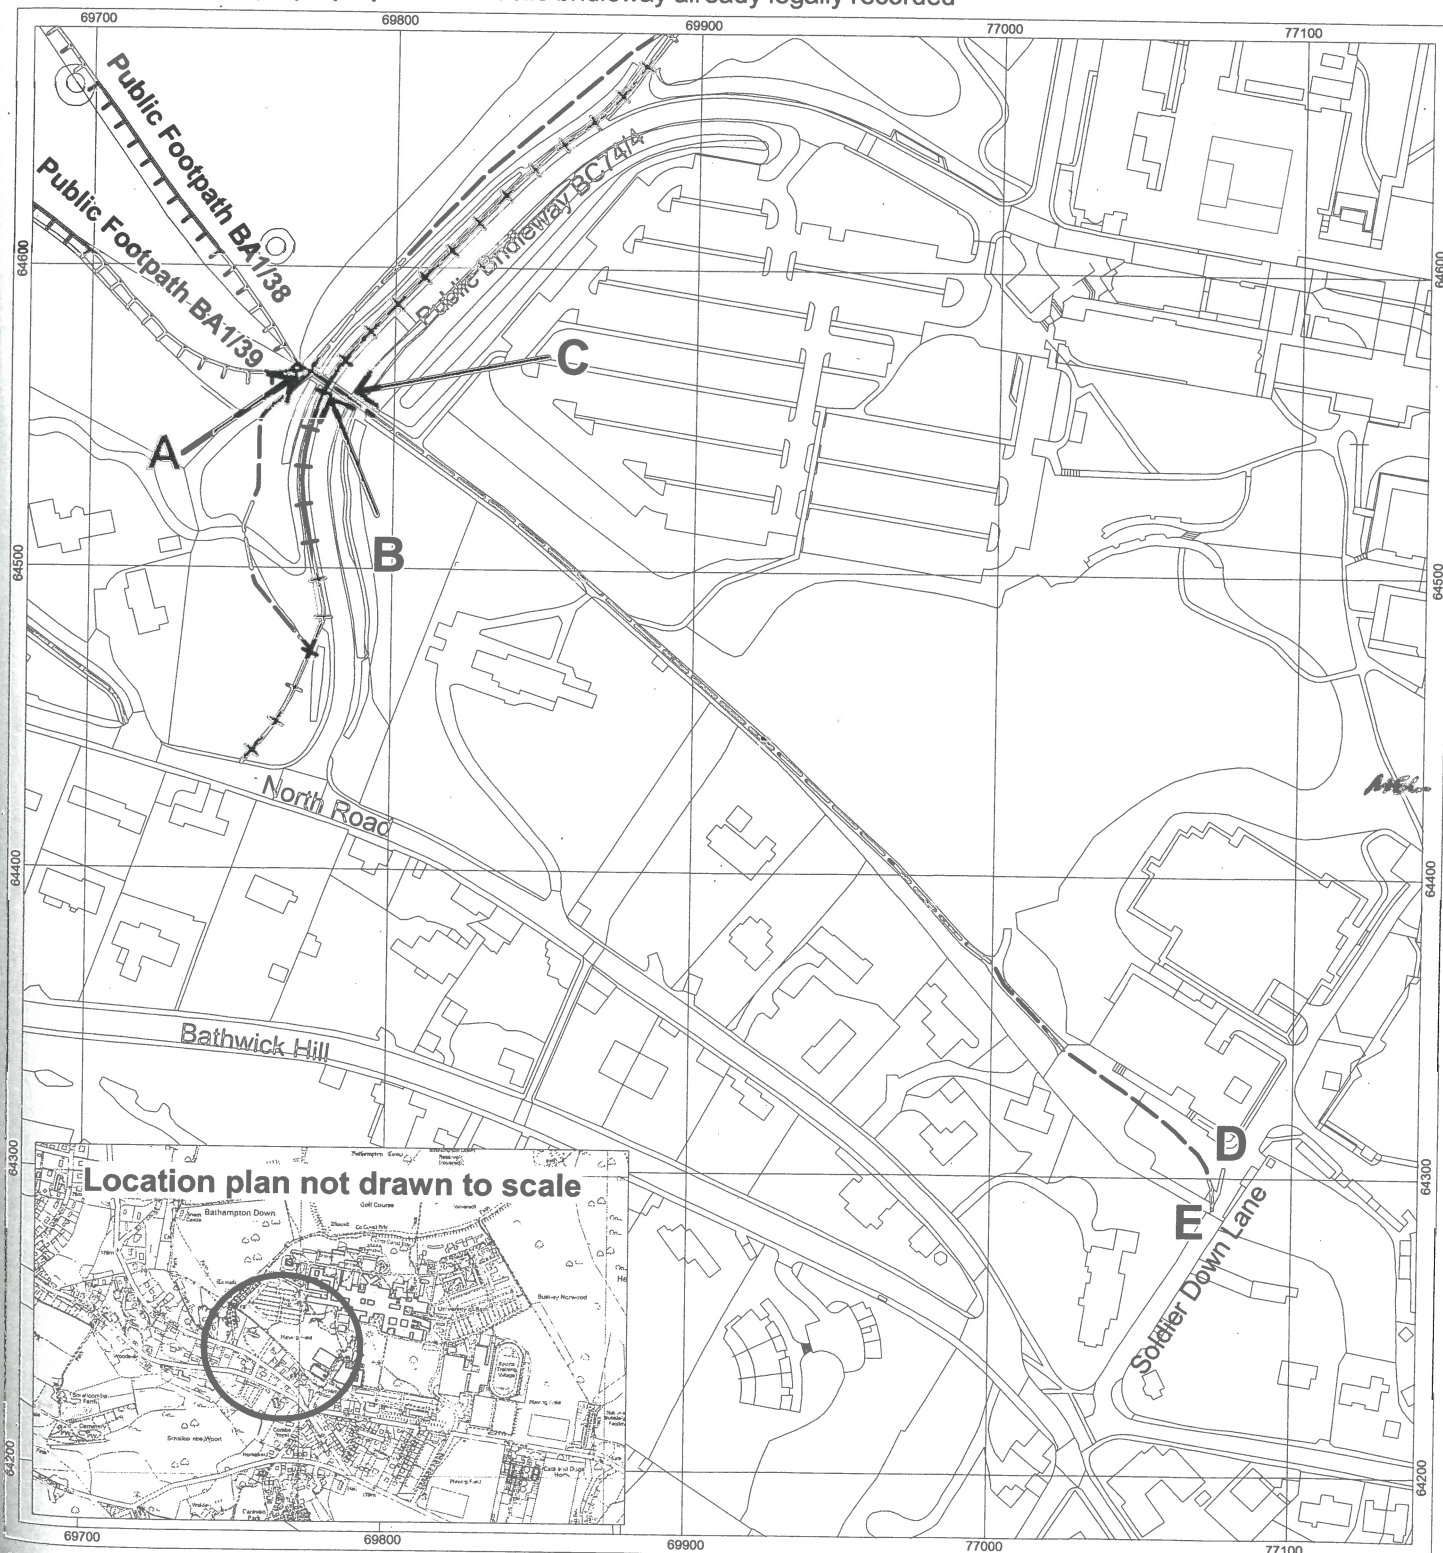

Location plan not drawn to scale

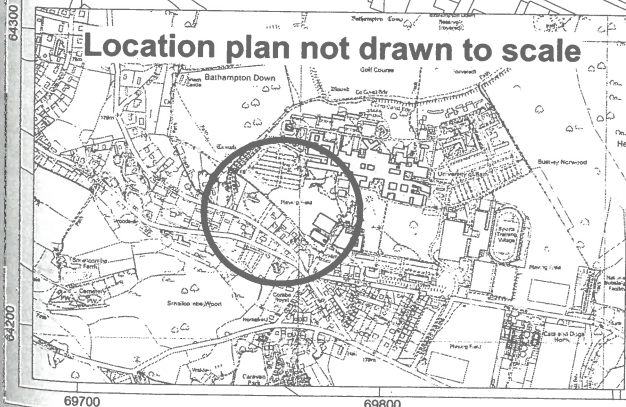

Wildlife & Countryside Act 1981

Part 9

Bath & North East Somerset Council

Public Footpath BC64/6 at Bathwick Ward, Bath. City of Bath Definitive Map and Statement Modification Order (No.11 - Bathwick & Combe Down) 2015

Key

Footpath to be added to the Definitive Map and Statement.



The width of the footpath to be recorded is shown shaded and varies between 1.8m - 3.0m

Order Map



Scale 1:1000

Other footpaths included in this Order



Wildlife & Countryside Act 1981 Part 10

Bath & North East Somerset Council

Public Footpath BC65/5 at Bathwick Ward, Bath. City of Bath Definitive Map and Statement
Modification Order (No.11 - Bathwick & Combe Down) 2015

Key

Footpath to be added to the Definitive Map and Statement.

A  **B**  **C**
ST 7642 6574 ST 7644 6572

The width of the footpath to be recorded is shown shaded and varies between 1.2m - 1.4m.


Order Map



Scale 1:1000



Unaffected other path

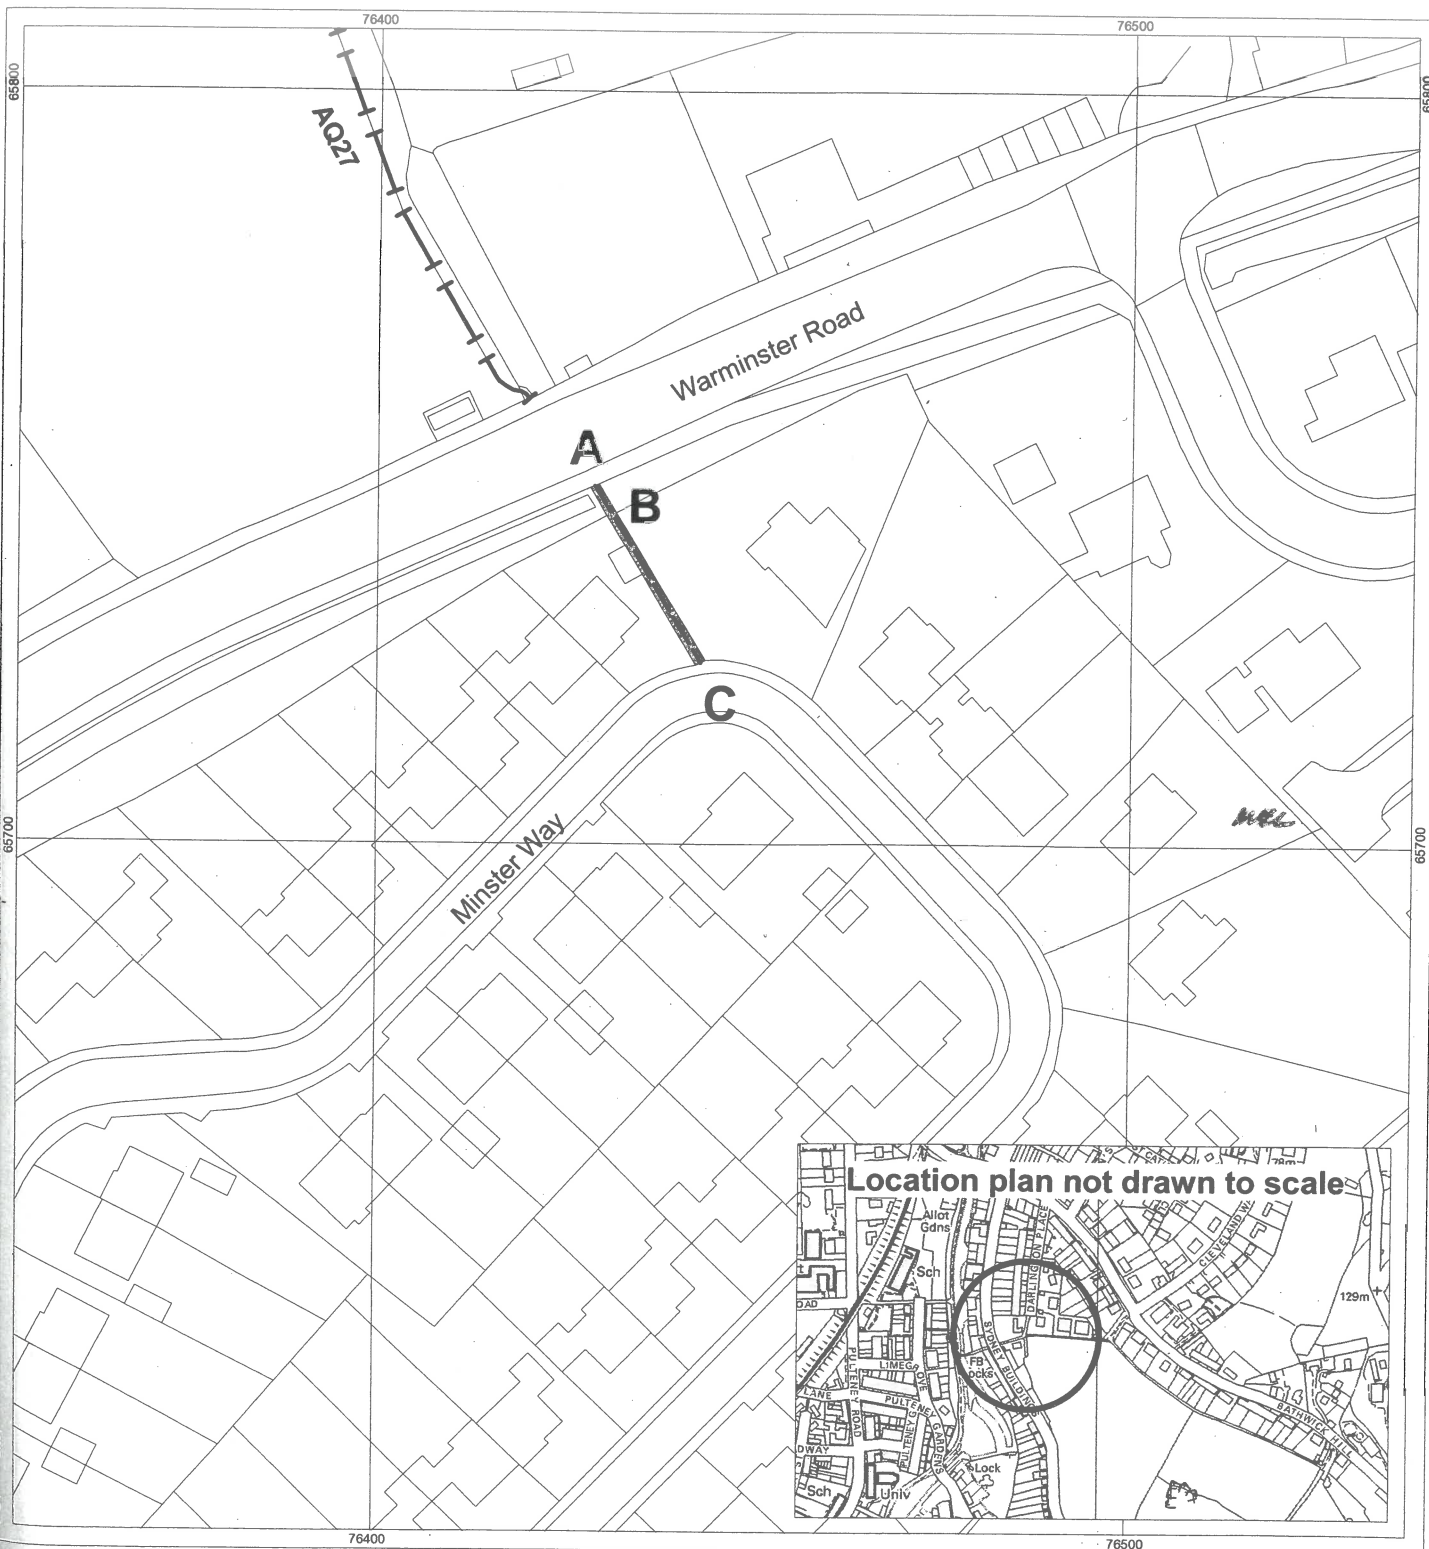

Location plan not drawn to scale

Wildlife & Countryside Act 1981

Part 11

Bath & North East Somerset Council

Public Footpath BC65/6 at Bathwick Ward, Bath. City of Bath Definitive Map and Statement
Modification Order (No.11 - Bathwick & Combe Down) 2015

Key

Footpath to be added to the Definitive Map and Statement.

A  **C**
ST 7608 6549 ST 7612 6547

The width of the footpath to be recorded is shown shaded and varies between 1.1m - 1.3m.


Order Map



Scale 1:1000



Public footpath already legally recorded

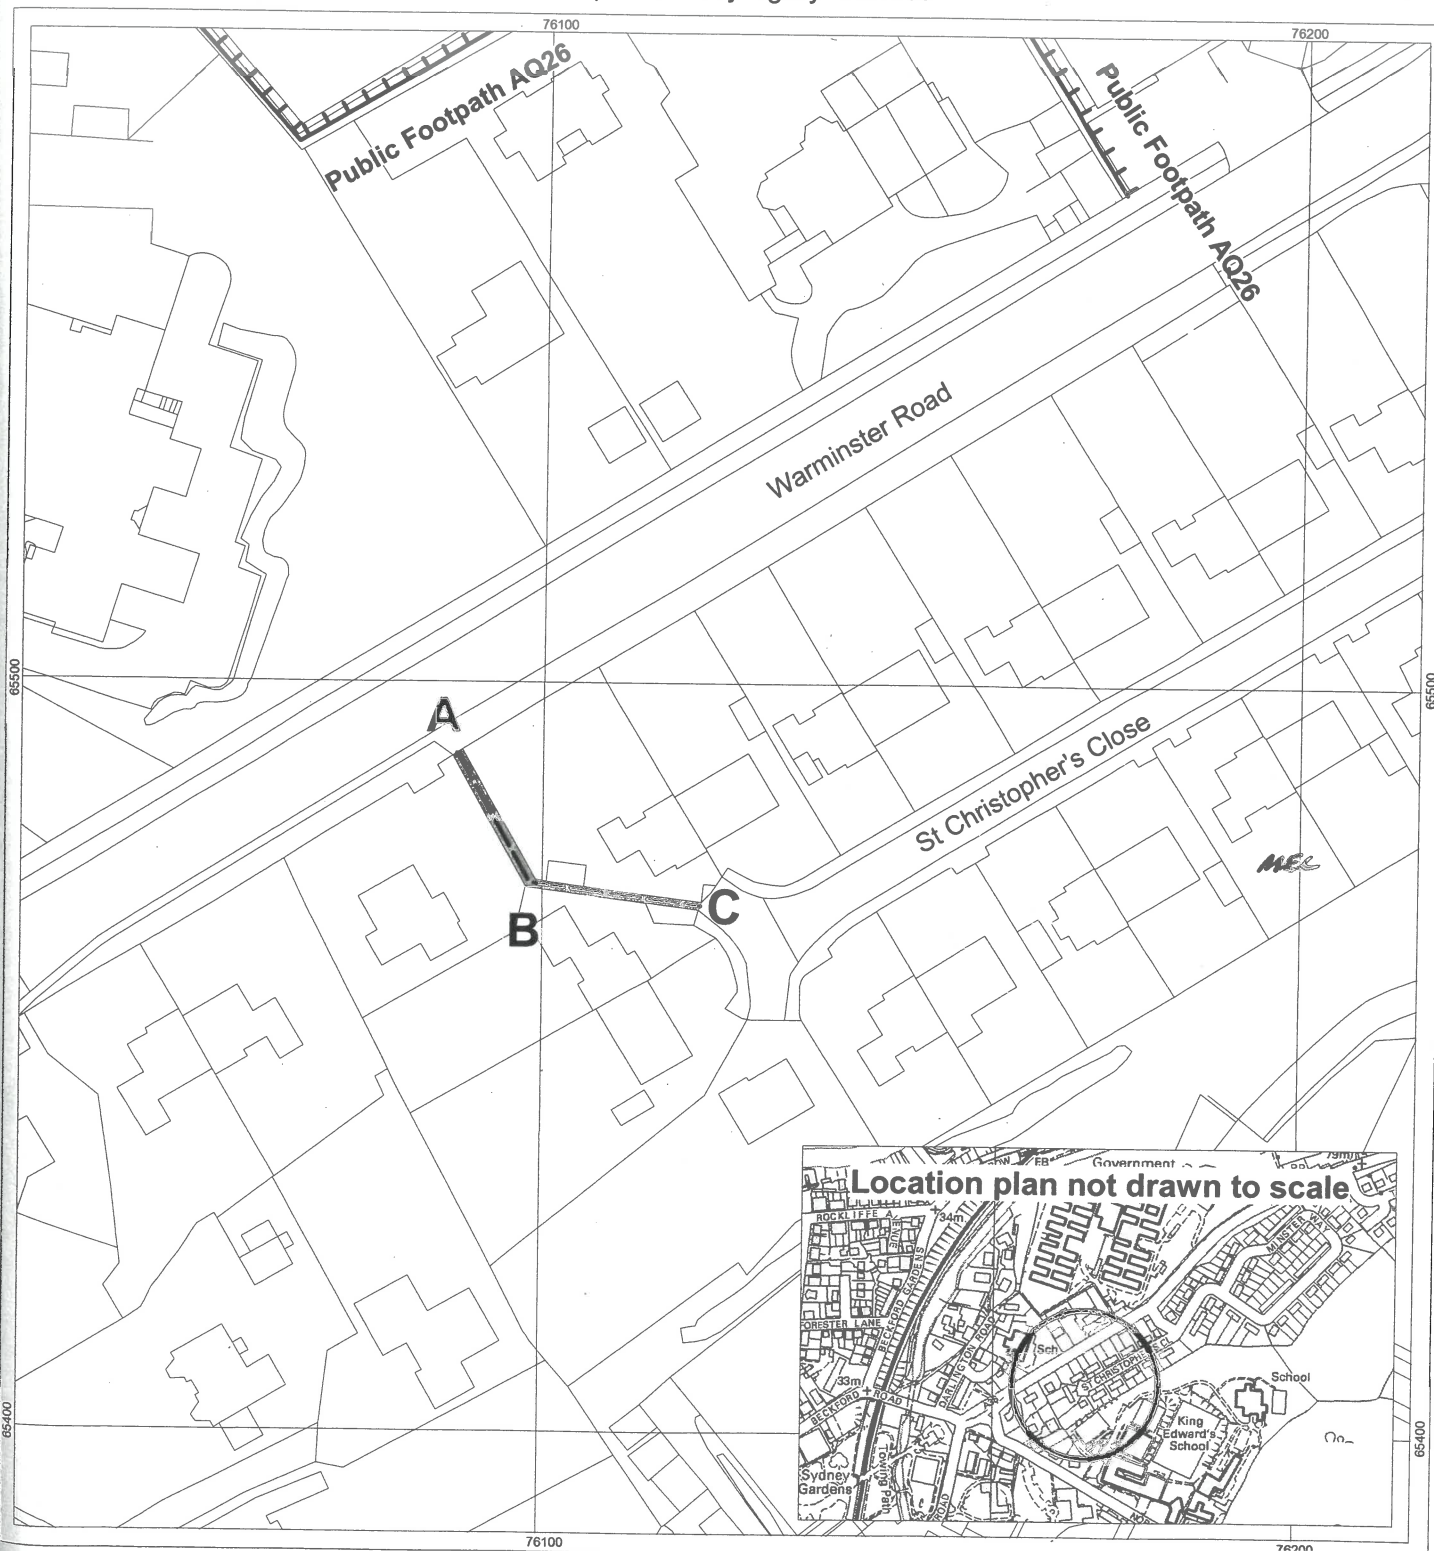

Wildlife & Countryside Act 1981

Part 12

Bath & North East Somerset Council

Public Footpath BC65/7 at Bathwick Ward, Bath. City of Bath Definitive Map and Statement Modification Order (No.11 - Bathwick & Combe Down) 2015

Key

Footpath to be added to the Definitive Map and Statement.

A  **B**  **C**
ST 7624 6504 ST 7636 6502

The width of the footpath to be recorded is shown shaded and varies between 1.3m - 4.1m.

Order Map



Scale 1:1250



Wildlife & Countryside Act 1981

Bath & North East Somerset Council Public Footpath BC72/1 at Combe Down Ward, Bath.
City of Bath Definitive Map and Statement Modification Order (No.11 - Bathwick & Combe Down) 2015

Part 13

Order Map





Scale 1:1000

Key Footpath to be added to the Definitive Map and Statement.

A — B — C — D — E
ST 7766 6294 ST 7793 6278

The width of the footpath to be recorded is 1.8m between points A to D, narrowing to 0.6m at point D.
The width of the footpath to be recorded is shown shaded between points D to E and varies between 0.6m to 1.6m.

 Public footpath already legally recorded

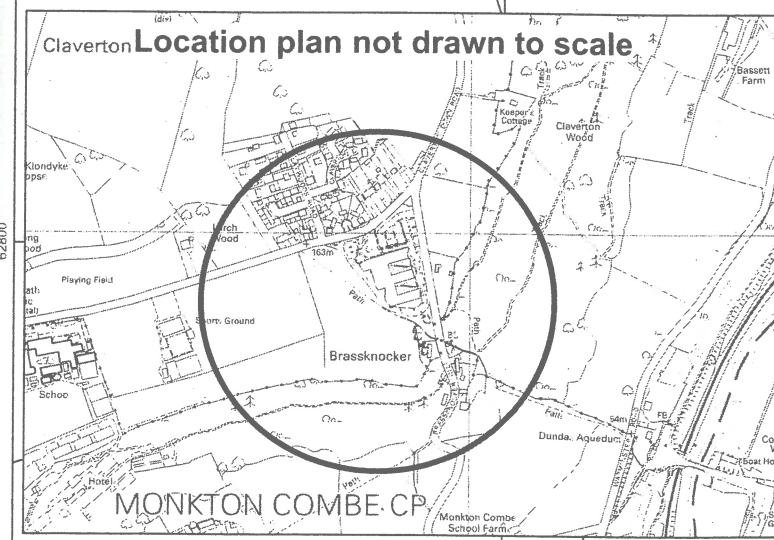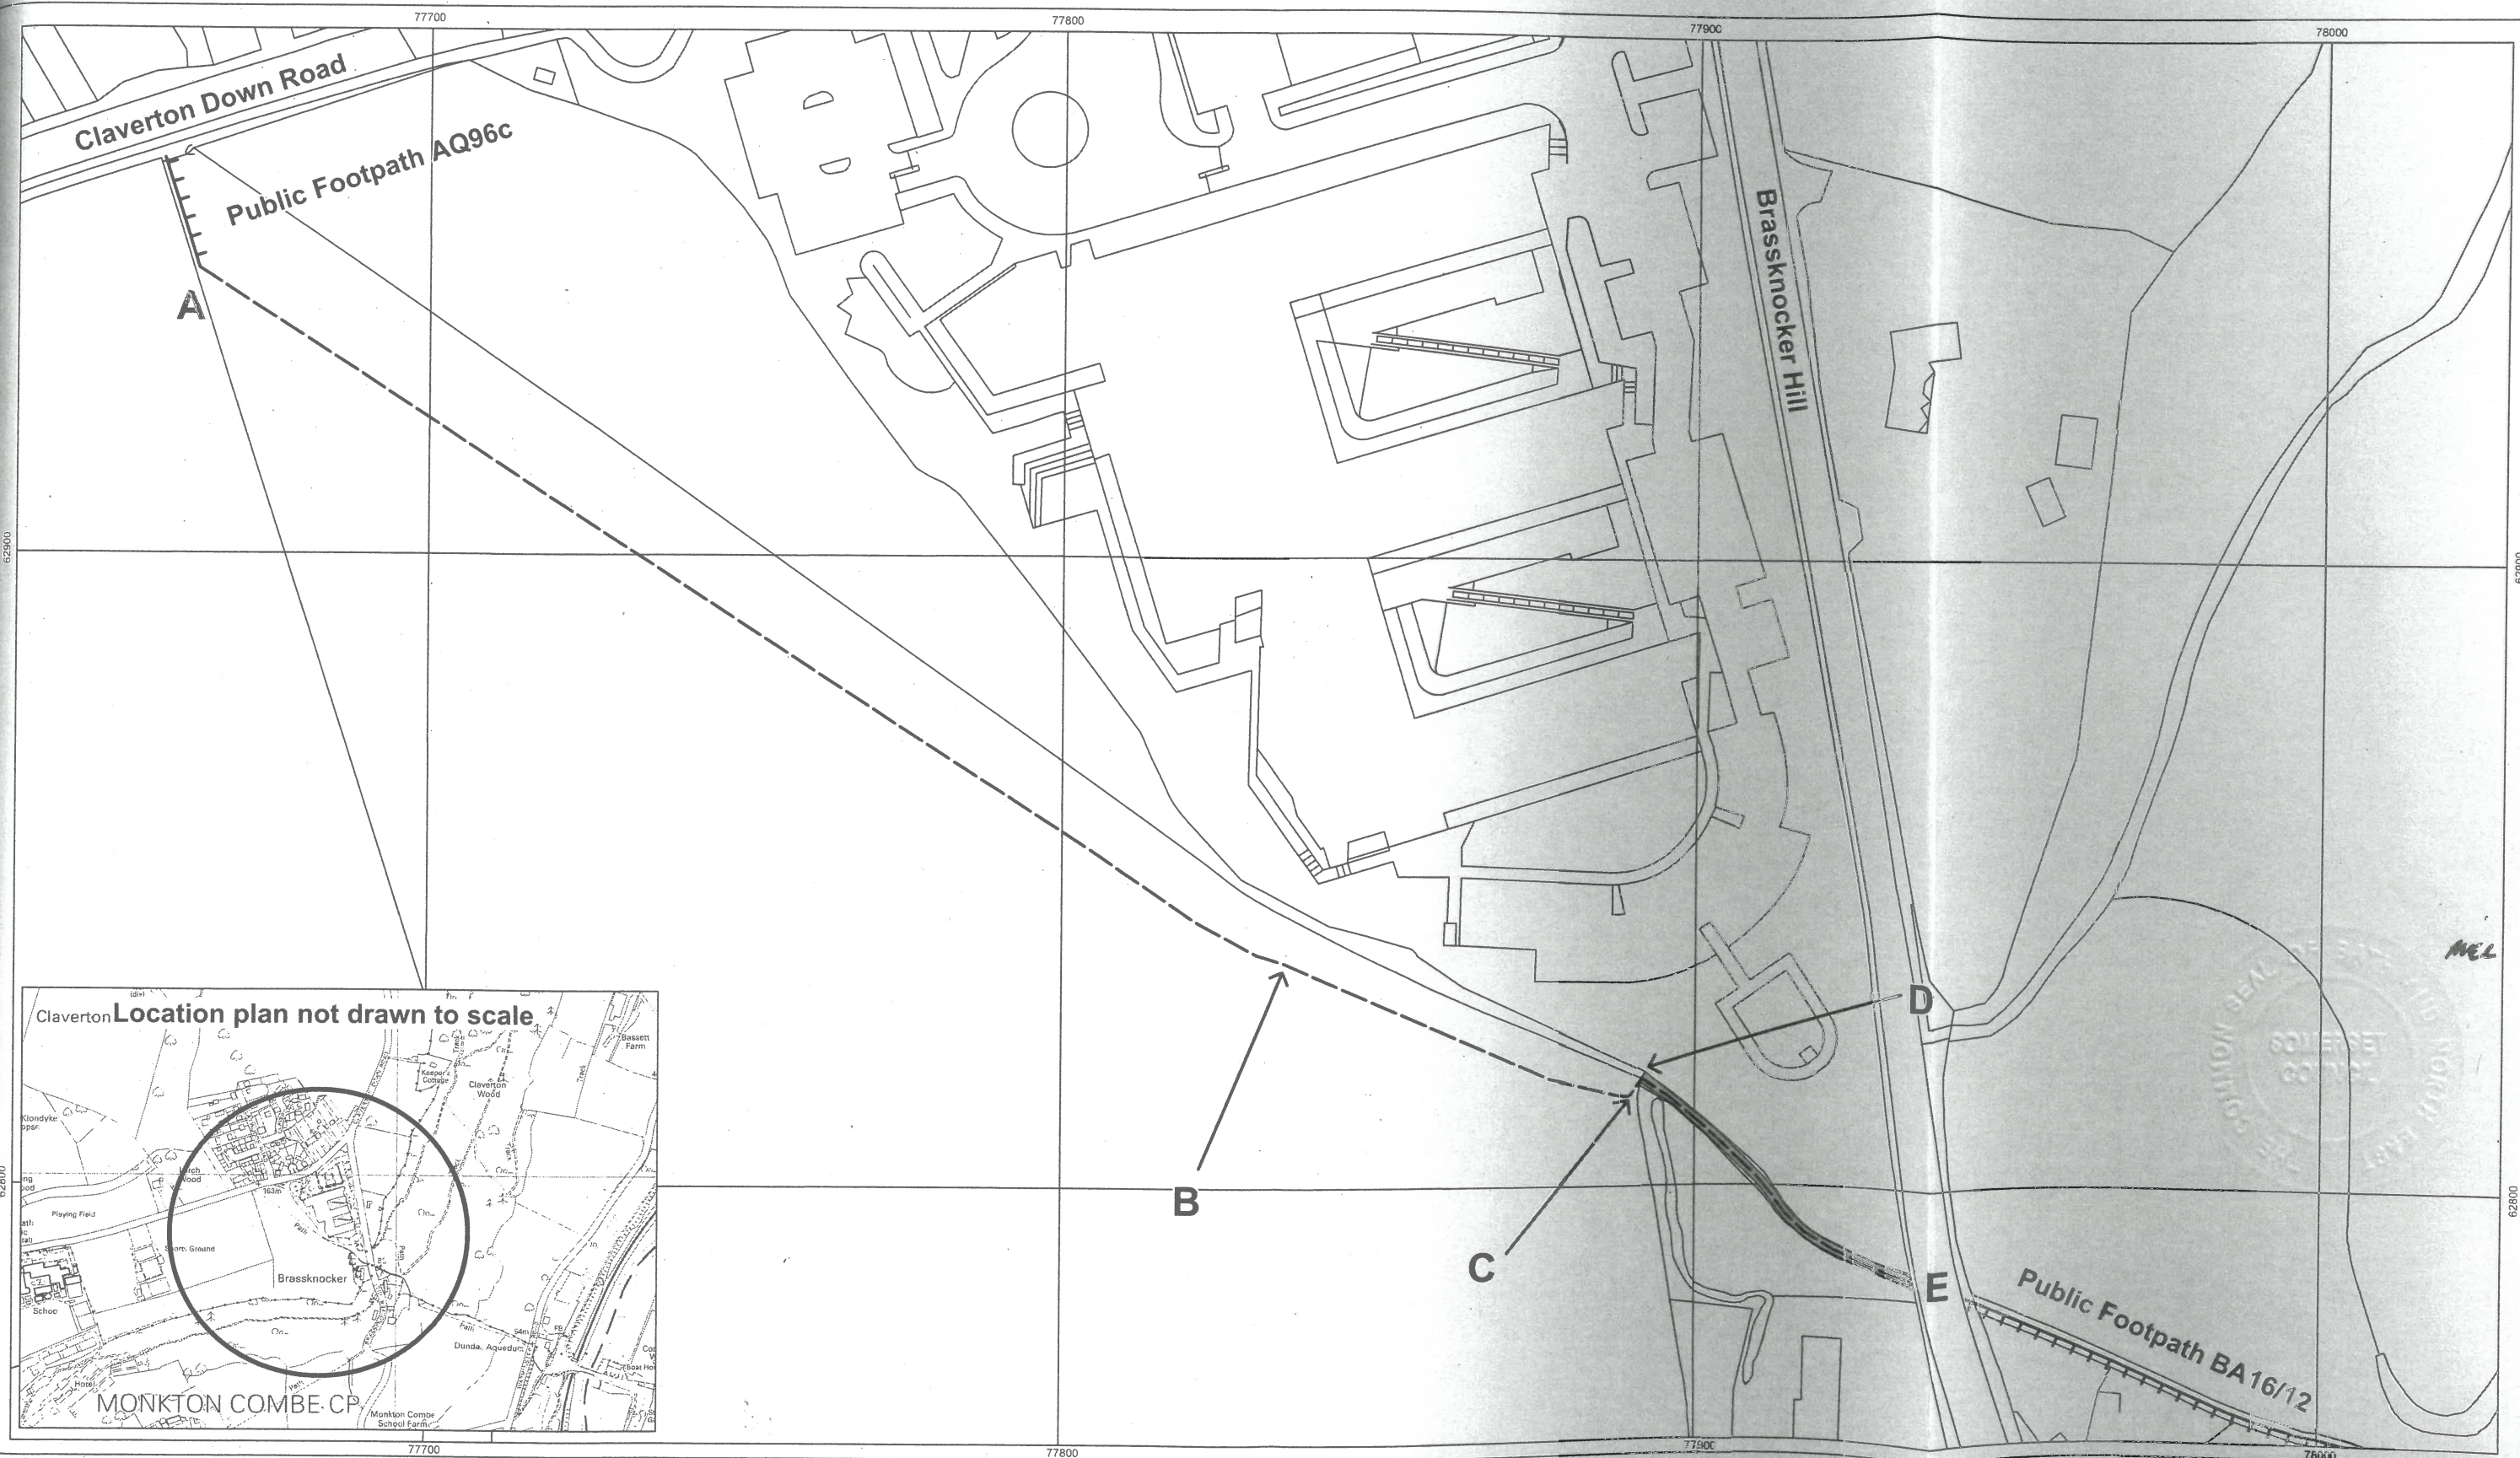

Wildlife & Countryside Act 1981 Part 14

Bath & North East Somerset Council

Public Footpath BC73/2 at Bathwick & Combe Down Wards, Bath. City of Bath Definitive Map and Statement Modification Order (No.11 - Bathwick & Combe Down) 2015

Key

Footpath to be added to the Definitive Map and Statement.


A - B - C - D - E - F - G - H The width of the footpath to be recorded is
ST 7717 6398 ST 7762 6296 1.8m between points A to F, 3m between points F to H

Order Map



Scale 1:10,000

- Other footpaths included in this Order
- + + + + + Bridleway included in this Order
- == == == == == Restricted Byway already legally recorded
- ||||| Public footpath already legally recorded

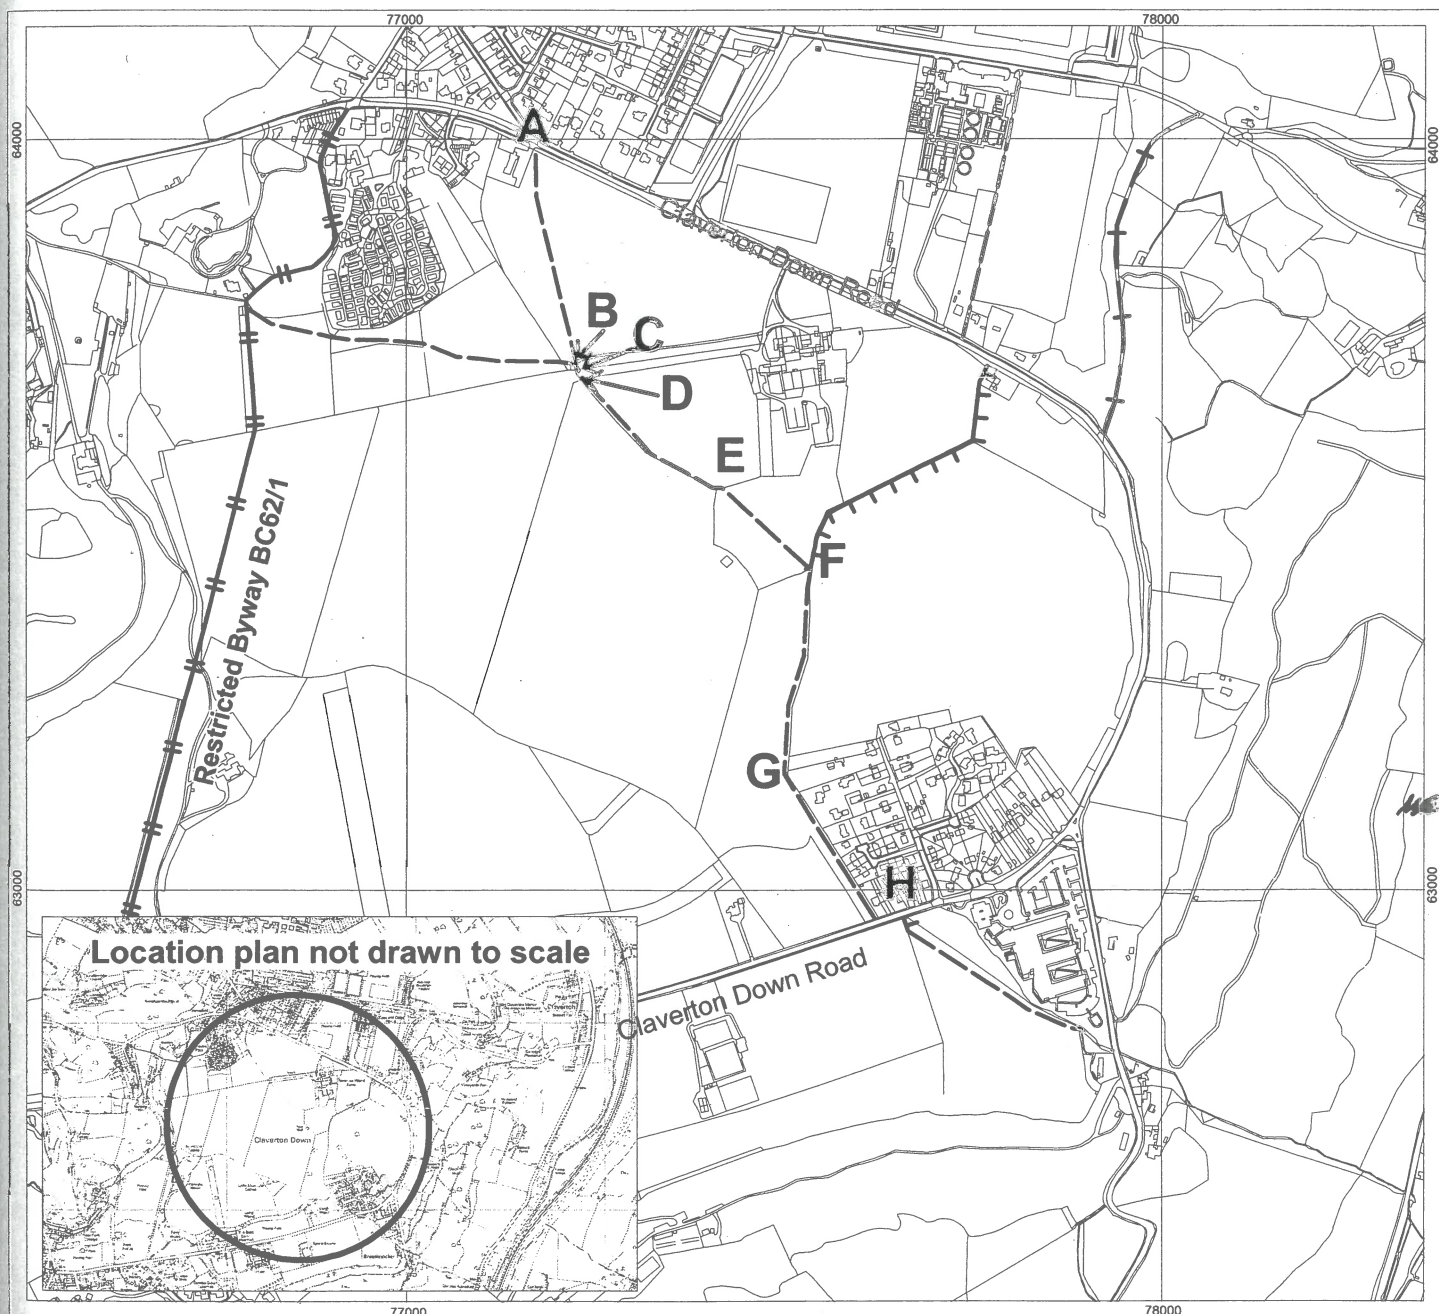

Location plan not drawn to scale

Claverton Down Road

Wildlife & Countryside Act 1981 Part 15

Bath & North East Somerset Council

Public Bridleway BC73/3 at Bathwick Ward, Bath. City of Bath Definitive Map and Statement
Modification Order (No.11 - Bathwick & Combe Down) 2015

Key

Bridleway to be added to the Definitive Map and Statement.

A  **B** The width of the bridleway to be recorded is shown shaded and varies between 2.9m - 8.2m.
ST 7792 6360 ST 7804 6403

Order Map



Scale 1:2500

 Footpath included in this Order
 Public footpath already legally recorded



Wildlife & Countryside Act 1981 Part 16

Bath & North East Somerset Council

Public Footpath BC74/2 at Bathwick Ward, Bath. City of Bath Definitive Map and Statement
Modification Order (No.11 - Bathwick & Combe Down) 2015

Key

Footpath to be added to the Definitive Map and Statement.

A ——— **B** ——— **C**
ST 7758 6447 ST 7745 6458

The width of the footpath to be recorded is 1.8m.



Public footpath already legally recorded




Public bridleway already legally recorded

Order Map



Scale 1:2000

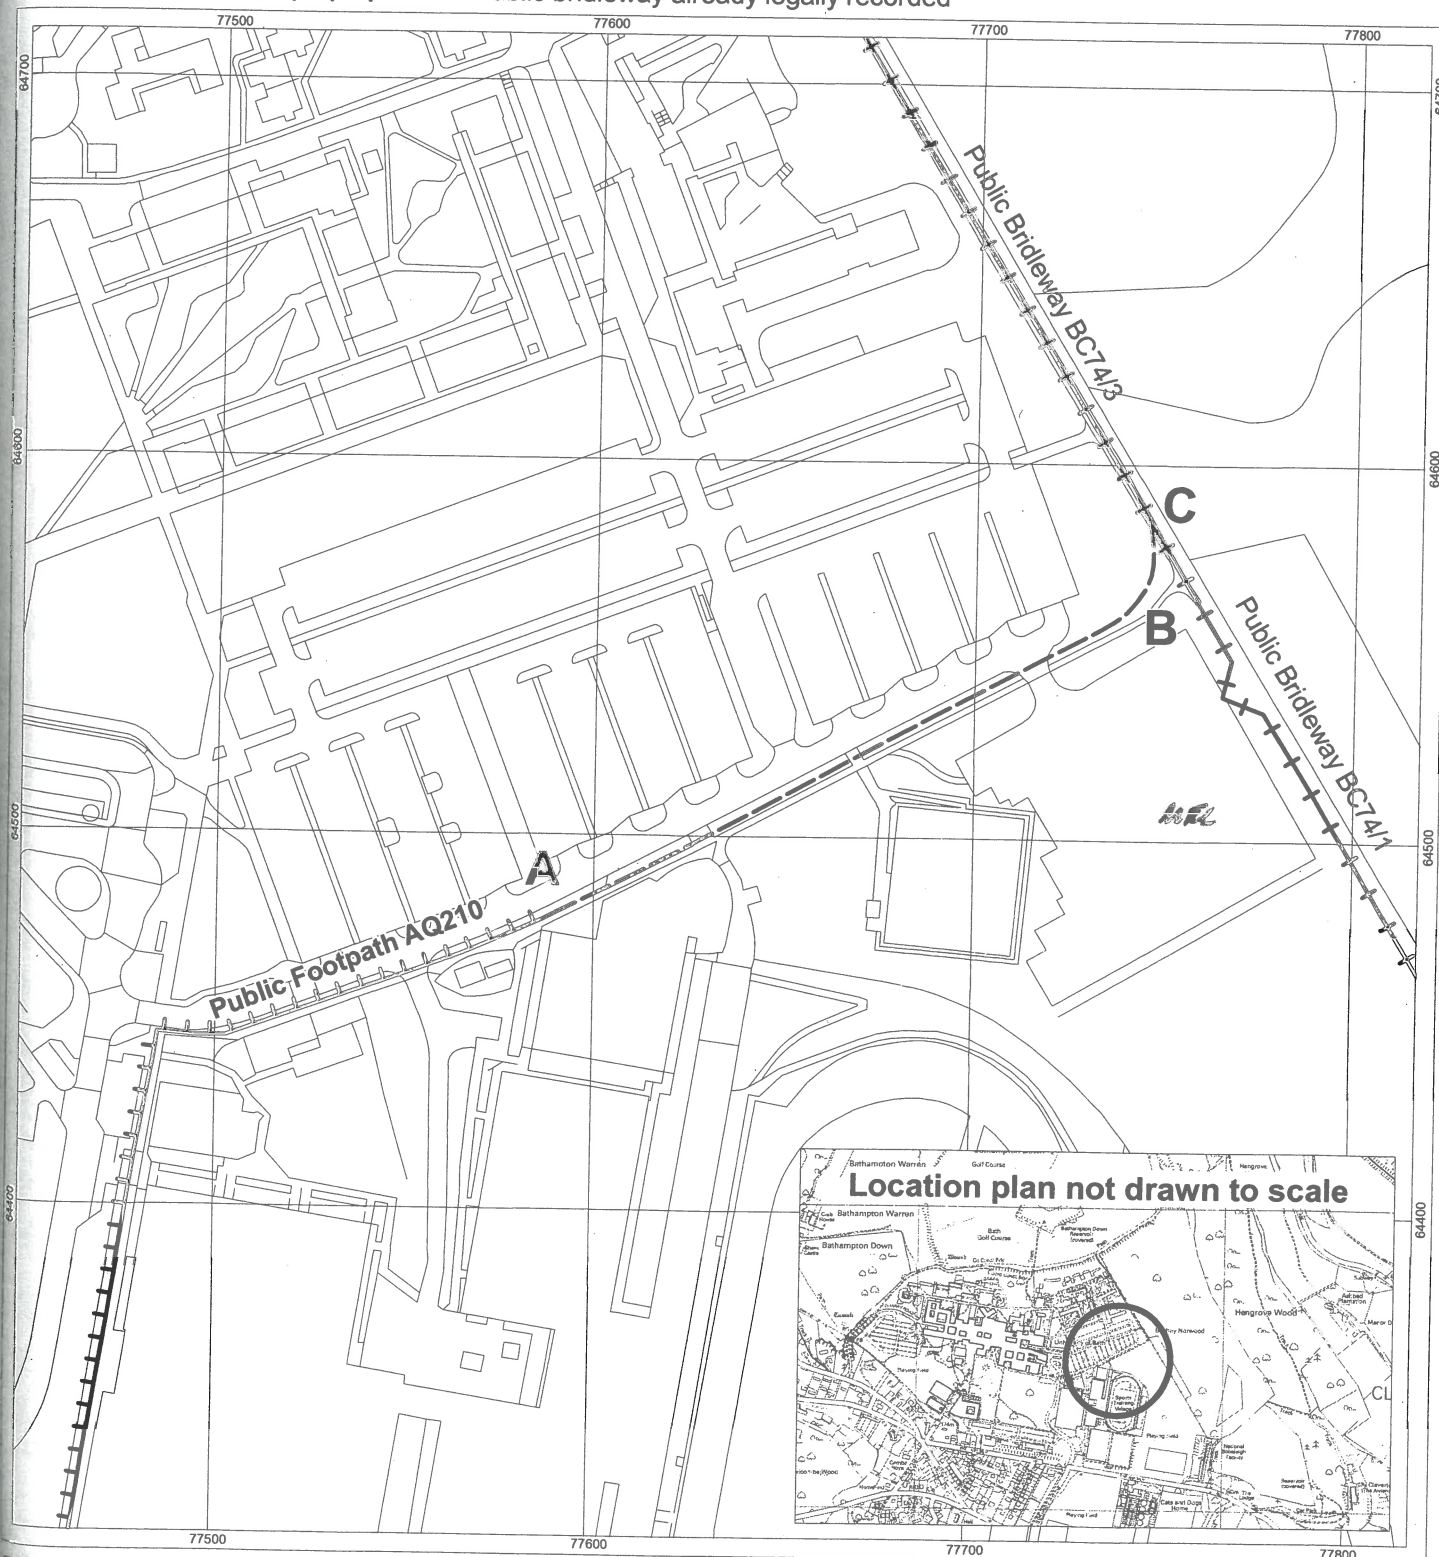

Location plan not drawn to scale

Key Footpath to be added to the Definitive Map and Statement.

A  **B**  **C** 
ST 7773 6373 ST 7774 6377 ST 7781 6408

The width of the footpath to be recorded is shown shaded and varies between 1.1m - 1.4m between points A to B. The width of the footpath to be recorded is 1.8m between points B to C, narrowing to 1.2m at point C.

 Bridleway included in this Order
 Public footpath already legally recorded
 Public bridleway already legally recorded

