

WILDLIFE AND COUNTRYSIDE ACT 1981

CITY OF BATH DEFINITIVE MAP AND STATEMENT

Bath and North East Somerset Council (City of Bath Definitive Map and Statement Modification Order) (No. 2 – Lansdown) 2005

This Order is made by Bath and North East Somerset Council under section 53(2)(b) of the Wildlife and Countryside Act 1981 ('the Act') because it appears to that authority that the City of Bath Definitive Map and Statement require modification in consequence of the occurrence of an event specified in section 53(3)(c)(i) namely, that a right of way which is not shown on the map and statement subsists or is reasonably alleged to subsist over land in the area to which the map relates, being a right of way to which this Part applies.

The authority has consulted with every local authority whose area includes the land to which the order relates. The Bath and North East Somerset Council hereby order that:

1. For the purposes of this order the relevant date is 20th July 2005.
2. The City of Bath Definitive Map and Statement shall be modified as described in Part I and Part II of the Schedule and shown on the map attached to the Order.
3. This order shall take effect on the date it is confirmed and may be cited as the Bath and North East Somerset Council (City of Bath Definitive Map and Statement Modification Order) (No. 2 – Lansdown) 2005.

Given under the Common Seal of the Bath and North East Somerset Council the 10th day of August 2005.

The COMMON SEAL of the
BATH AND NORTH EAST SOMERSET
COUNCIL
was hereunto affixed
in the presence of:-



AC Brooks

Authorised signatory

AUTHORITY FOR SEALING	
Regulatory (Access) Committee	
Council resolution _____	
Committee minute 8 of 12/7/05	
Initialed..... KE	

The foregoing order is hereby confirmed
subject to the red ink modifications thereon

Heidi Cruickshank

An Inspector appointed by The Secretary
of State for Environment, Food and
Rural Affairs

25 JUN 2014

In pursuance of its powers conferred by Schedule 15 of the Wildlife and Countryside Act 1981, the Council hereby confirms the above Order. However, that part of the order which relates to Footpaths AQ327 and AQ341 shall be treated as having been severed from this order and is to be treated as a separate order. These footpaths will therefore not form part of this order for confirmation purposes.

The COMMON SEAL of
BATH AND NORTH EAST SOMERSET
COUNCIL
was hereunto affixed
this 16th day of November 2005
in the presence of:-



AK Brookes

Authorised signatory

AUTHORITY FOR SEALING	
Regulatory (Access) Committee	
Council resolution	8.12.05
Committee minute	8.12.05
Initials	K.E.

SCHEDULE

PART I

Modification of Definitive Map

Description of path or way to be added

AQ8

A footpath in Bath in the District of Bath and North East Somerset running from point A on Sion Hill at Grid Reference ST 74339 66008 in a north easterly direction for a distance of approximately 1m to point B at Grid Reference ST 74339 66009 where it ascends a flight of steps for a distance of approximately 7m and continues for a distance of approximately 4m to point C at Grid Reference ST 74346 66018 where it ascends a flight of steps for a distance of approximately 4m and continues for a distance of approximately 5m to point D at Grid Reference ST 74351 66025 where it ascends a flight of steps for a distance of approximately 3m and continues for a distance of approximately 7m to point E at Grid Reference ST 74357 66033 where it ascends a flight of steps for a distance of approximately 3m and continues for a distance of approximately 5m to point F at Grid Reference ST 74361 66039 where it ascends a flight of steps for a distance of approximately 1m to a lamp post at point G at Grid Reference ST 74362 66040 and continues up steps for a distance of approximately 3m to where it ends at point H on Somerset Place at Grid Reference ST 74364 66043 and shown by a broken black line with short intervals marked A – H on the map numbered AQ8 annexed to this order, the number of this footpath to be known as BC46/4.

AQ9

A footpath in Bath in the District of Bath and North East Somerset starting at point A on Mount Beacon at Grid Reference ST 7504 6607 at the top of a steep slope and continuing in a south easterly direction for a distance of approximately 3m to point B at Grid Reference ST 75045 66066, where the direction changes to south-south westerly for a distance of approximately 24m to point C at Grid Reference ST 75037 66044, where the direction changes to south-south easterly for a distance of approximately 8m to point D at Grid Reference ST 75040 66037, where the direction changes to south-south westerly for a distance of approximately 32m to point E at Grid Reference ST 75035 66007, where the direction changes to north easterly for a distance of approximately 26m to point F at Grid Reference ST 75053 66026 where the direction changes to southerly for a distance of approximately 22m to point G at Grid Reference ST 75052 66005, where the direction changes to south westerly for a distance of approximately 4m to where it ends at point H on Rivers Road at Grid Reference ST 7506 6600 and shown by a broken black line with short intervals marked A – H on the map numbered AQ9 annexed to this order, the number of this footpath to be known as BC56/2.

AQ10

A footpath in Bath in the District of Bath and North East Somerset running from point A on Rivers Road at Grid Reference ST 7510 6604 in a south easterly direction for a distance of approximately 6m to point B at Grid Reference ST 75107 66039, before continuing in a south westerly direction for a distance of approximately 19m to point C at Grid Reference ST 75096 66024 where the direction changes to south-south westerly for a distance of approximately 2m to point D at Grid Reference ST 75096 66021 where the direction changes to south-south easterly for a distance of approximately 56m to where it ends at point E on Camden Road at Grid Reference ST 7512 6597 and shown by a broken black line with short intervals marked A – E on the map numbered AQ10 annexed to this order, the number of this footpath to be known as BC56/3.

AQ10a(part of AQ10)

A footpath in Bath in the District of Bath and North East Somerset running from point A on Camden Road at Grid Reference ST 7510 6596, in a generally north easterly direction up a flight of steps for a distance of approximately 15m to point B at Grid Reference ST 7509 6597 where the direction changes to north westerly for a distance of approximately 27m to where it ends at point C at Grid Reference ST 7511 6599 and shown by a broken black line with short intervals marked A – C on the map numbered AQ10a annexed to this order, the number of this footpath to be known as BC55/3.

AQ21

A footpath in Bath in the District of Bath and North East Somerset running from point A on Portland Place at Grid Reference ST 7468 6565, up a short flight of steps in a north-north easterly direction for a distance of approximately 3m to 2 posts at point B at Grid Reference ST 74677 65652, before continuing for a distance of approximately 66m to point C at Grid Reference ST 7470 6571 where the direction changes to north easterly for a distance of approximately 56m to where it ends at point D on Lansdown Road at Grid Reference ST 7474 6575 and shown by a broken black line with short intervals marked A – D on the map numbered AQ21 annexed to this order, the number of this footpath to be known as BC45/10.

AQ195

A footpath in Bath in the District of Bath and North East Somerset running from point A on St Stephen's Road at Grid Reference ST 7501 6592 in a north easterly direction for a distance of approximately 95m to where it ends at point B on Rivers Road at Grid Reference ST 7506 6601 and shown by a broken black line with short intervals marked A – B on the map numbered AQ195 annexed to this order, the number of this footpath to be known as BC55/1.

AQ196

A footpath in Bath in the District of Bath and North East Somerset running from point A on St Stephen's Road at Grid Reference ST 7502 6592 in a north easterly direction for a distance of approximately 95m to where it ends at point B on Rivers Road at Grid Reference ST 7507 6600 and shown by a broken black line with short intervals marked A – B on the map numbered AQ196 annexed to this order, the number of this footpath to be known as BC55/2.

AQ327

A footpath in Bath in the District of Bath and North East Somerset running from point A on St Stephen's Road at Grid Reference ST 7491 6582 in a north-north easterly direction for a distance of approximately 108m to point B at Grid Reference ST 7495 6592 where the direction changes to north easterly for a distance of approximately 127m to point C at Grid Reference ST 7503 6602 where the direction changes to north-north easterly for a distance of approximately 42m to point D on Mount Beacon where it ends at Grid Reference ST 7504 6606 and shown by a broken black line with short intervals marked A – D on the map numbered AQ327 annexed to this order, the number of this footpath to be known as BC45/6.

AQ341

A footpath in Bath in the District of Bath and North East Somerset running from point A on St Stephen's Road at Grid Reference ~~ST 7487 6590~~ T 7486 6589 for a distance of approximately 101m for a distance of approximately ~~98m~~ to point B where it ends on Mount Road at Grid Reference ST 7496 6593 and shown by a broken black line with short intervals marked A – B on the map numbered AQ341 annexed to this order, the number of this footpath to be known as BC45/5.

AQ342

A footpath in Bath in the District of Bath and North East Somerset running from point A on Park Street at Grid Reference ST 7450 6585 in a north easterly direction for a distance of approximately 10m to point B at Grid Reference ST 7451 6586 where the direction changes to east- north easterly for a distance of approximately 14m to 2 posts at point C at Grid Reference ST 7453 6586 and continuing for a distance of approximately 24m to point D at Grid Reference ST 7455 6587 where the direction changes to northerly for a distance of approximately 46m to 2 posts at point E where it ends on All Saints Road at Grid Reference ST 7455 6592 and shown by a broken black line with short intervals marked A – E on the map numbered AQ342 annexed to this order, the number of this footpath to be BC45/4.

BQ2

A footpath in Bath in the District of Bath and North East Somerset running from 2 staggered barriers at point A on Northfields Close at Grid Reference ST 7479 6623 in an easterly direction for a distance of approximately 40m to another set of staggered barriers at point B where it ends on Richmond Road at Grid Reference ST 7483 6623 and shown by a broken black line with short intervals marked A – B on the map

numbered BQ2 annexed to this order, the number of this footpath to be known as BC46/2.

BQ20

A footpath in Bath in the District of Bath and North East Somerset running from point A on St Stephen's Road at Grid Reference ST 7485 6594 and up a short flight of steps for a distance of approximately 5m and continues in an east-north easterly direction for a distance of approximately 23m to where it ends at point B on St Stephen's Close at Grid Reference ST 7488 6595 and shown by a broken black line with short intervals marked A – B on the map numbered BQ20 annexed to this order, the number of this footpath to be known as BC45/3.

CQ13

A footpath in Bath in the District of Bath and North East Somerset running from point A on Mount Beacon at Grid Reference ST 7508 6619 in a north easterly direction for a distance of approximately 15m to 2 posts at point B at Grid Reference ST 7509 6620 and continuing for a distance of approximately 39m to point C at Grid Reference ST 7512 6622 where the direction changes to easterly and continues for a distance of approximately 36m to 4 posts at point D where it ends on Richmond Place at Grid Reference ST 7515 6623 and shown by a broken black line with short intervals marked A – D on the map numbered CQ13 annexed to this order, the number of this footpath to be known as BC56/1.

CQ57

A footpath in Bath in the District of Bath and North East Somerset running down a flight of steps from point A on St Stephen's Road at Grid Reference ST 7497 6581 in a north easterly direction for a distance of approximately 2m to point B at Grid Reference ST 74972 65813 where the direction changes to east-north easterly for a distance of approximately 4m to point C at ST 7497 6581 where the direction changes to north easterly for a distance of approximately 12m to point D at Grid Reference ST 7498 6582 and continuing in a south-south easterly direction for a distance of approximately 16m to where it ends at point E on St Stephen's Road at Grid Reference ST 7499 6581 and shown by a broken black line with short intervals marked A – E on the map numbered CQ57 annexed to this order, the number of this footpath to be known as BC45/7.

PART II

Modification of Definitive Statement

Path Number: BC46/4
Ward / Parish: Lansdown

Status: Footpath
Width: Varies between 2.2m – 3.6m, as shown shaded on the Order Plan

Length: Approximately 43m

Description of Route			
From	General Direction	To	
County Road or Right of Way	Grid Ref:	County Road or Right of Way	Grid Ref:
Sion Hill	ST 7434 6601	NE	Somerset Place
			ST 7436 6604

General Description:

The footpath starts on Sion Hill and continues up five flights of paved steps in a north easterly direction for a distance of approximately 43m to where it ends on Somerset Place.

Non Conclusive Evidence	Conditions and Limitations	Position	Conclusive Evidential Provisions
Survey Date: 04/11/2004 & 16/05/2005			
Previous Path Number: AQ8	Steps	ST 74339 66009	2.5m
Reason for inclusion:	Steps	ST 74346 66018	2.5m
Order to be made under s53(3)(c)(i) Wildlife & Countryside Act 1981. Bath and North East Somerset Council, City of Bath Definitive Map and Statement Modification Order (No.2 - Lansdown) 2005.	Steps	ST 74351 66025	2.5m – 2.6m
	Steps	ST 74357 66033	2.6m
	Steps	ST 74361 66039	2.2m - 2.7m
	Lamp Post	ST 74362 66040	2.6m
Legal Basis for Making the Order:			
s53(3)(c)(i) Wildlife and Countryside Act 1981.			

Modification of Definitive Statement

Path Number: BC56/2
Ward / Parish: Lansdown

Status: Footpath
Width: Varies between 1.4m – 3.9m, as shown shaded on the Order Plan

		Description of Route			
		General Direction		To	
County Road or Right of Way	Grid Ref.			County Road or Right of Way	Grid Ref.
Mount Beacon	ST 7504 6607	S		Rivers Road	ST 7506 6600

General Description:

The footpath starts on Mount Beacon at the top of a steep slope and continues along a natural surface in a south easterly direction for a distance of approximately 3m, where the direction changes to south-south westerly for a distance of approximately 24m, where the direction changes to south-south westerly for a distance of approximately 8m, where the direction changes to south-south westerly for a distance of approximately 32m, where the direction changes to north easterly for a distance of approximately 26m, where the direction changes to southerly for a distance of approximately 22m, where the direction changes to south westerly for a distance of approximately 4m to where it ends on Rivers Road.

Non Conclusive Evidence	Conditions and Limitations	Conclusive Evidential Provisions
<p>Previous Path Number: AQ9</p> <p>Reason for inclusion:</p> <p>Order to be made under s53(3)(c)(i) Wildlife & Countryside Act 1981. Bath and North East Somerset Council, City of Bath Definitive Map and Statement Modification Order (No.2 - Lansdown) 2005.</p> <p>Legal Basis for Making the Order:</p> <p>s53(3)(c)(i) Wildlife and Countryside Act 1981.</p>		

Modification of Definitive Statement

Path Number: BC56/3
Ward / Parish: Lansdown

Status: Footpath
Width: Varies between 1.5m – 4.7m, as shown shaded on the Order Plan

Description of Route			
From	General Direction	To	Grid Ref:
County Road or Right of Way		County Road or Right of Way	
Rivers Road	ST 7510 6604	ST 7512 6597	Camden Road

General Description:

The footpath starts on Rivers Road and continues down a tarmac path in a south easterly direction for a distance of approximately 6m where the direction changes to south westerly for a distance of approximately 19m where the direction changes to south-south easterly for a distance of approximately 39m to where the path widens to include a pavement and continues for a further 17m to where it ends on Camden Road.

Non Conclusive Evidence	Conditions and Limitations	Position	Conclusive Evidential Provisions
Survey Date: 04/11/2004 & 16/05/2005			
Previous Path Number: AQ10			
Reason for inclusion: Order to be made under s53(3)(c)(i) Wildlife & Countryside Act 1981. Bath and North East Somerset Council, City of Bath Definitive Map and Statement Modification Order (No.2 - Lansdown) 2005.			
Legal Basis for Making the Order: s53(3)(c)(i) Wildlife and Countryside Act 1981.			

Modification of Definitive Statement

Path Number: BC55/3
Ward / Parish: Lansdown

Status: Footpath
Width: Varies between 1.9m - 2.7m, as shown shaded on the Order Plan

Description of Route			
From	General Direction	To	
County Road or Right of Way		County Road or Right of Way	Grid Ref:
Camden Road	ST 7510 6596	S	Camden Terrace ST 7511 6599

General Description:

The footpath starts on Camden Road and continues up a flight of paved steps in a generally north easterly direction for a distance of approximately 15m to the top of the steps where the direction changes to north westerly for a distance of approximately 27m to where it ends on Camden Terrace.

Non Conclusive Evidence	Survey Date: 04/11/2004 & 16/05/2005	Conditions and Limitations	Position	Conclusive Evidential Provisions
Previous Path Number: AQ10 (part of AQ10)		Steps	ST 75096 65966	Width 2.5m - 2.7m
Reason for inclusion:	<p>Order to be made under s53(3)(c)(i) Wildlife & Countryside Act 1981. Bath and North East Somerset Council, City of Bath Definitive Map and Statement Modification Order (No.2 - Lansdown) 2005.</p>			
Legal Basis for Making the Order:	<p>s53(3)(c)(i) Wildlife and Countryside Act 1981.</p>			

Modification of Definitive Statement

Path Number: BC45/10
Ward / Parish: Lansdown

Status: Footpath
Width: Varies between 3.0m – 4.2m, as shown shaded on the Order Plan

Description of Route			
From	General Direction	To	
County Road or Right of Way	Grid Ref:	County Road or Right of Way	Grid Ref:
Portland Place	ST 7468 6565	NNE	Lansdown Road
			ST 7474 6575

General Description:

The footpath starts on Portland Place and continues up a short flight of concrete steps in a north-north easterly direction for a distance of approximately 3m to 2 posts, before continuing for a distance of approximately 66m to where the direction changes to north easterly for a distance of approximately 56m to where it ends on Lansdown Road.

Non Conclusive Evidence	Conditions and Limitations	Conclusive Evidential Provisions
Survey Date: 03/11/2004 and 16/05/2005		Position
Previous Path Number: AQ21 Reason for inclusion: Order to be made under s53(3)(c)(i) Wildlife & Countryside Act 1981. Bath and North East Somerset Council, City of Bath Definitive Map and Statement Modification Order (No.2 - Lansdown) 2005.	Steps Post Post	ST 74676 65649 ST 74677 65652 ST 7474 6575
Legal Basis for Making the Order: s53(3)(c)(i) Wildlife and Countryside Act 1981.		3.0m – 3.2m 3.2m 3.0m

Modification of Definitive Statement

Path Number: BC55/1
Ward / Parish: Lansdown

Status: Footpath
Width: Varies between 2.1m – 3.7m, as shown shaded on the Order Plan

Description of Route			
From	General Direction	To	
County Road or Right of Way	Grid Ref:	County Road or Right of Way	Grid Ref:
St Stephen's Road	ST 7501 6592	NE	Rivers Road

General Description:
The footpath starts on St Stephen's Road and continues in a north easterly direction along a tarmac path for a distance of approximately 95m to where it ends on Rivers Road.

Non Conclusive Evidence	Conditions and Limitations	Conclusive Evidential Provisions
Survey Date: 04/11/2004 and 16/05/2005		Position ST 7501 6592
Previous Path Number: AQ195 Reason for inclusion: Order to be made under s53(3)(c)(i) Wildlife & Countryside Act 1981. Bath and North East Somerset Council, City of Bath Definitive Map and Statement Modification Order (No.2 - Lansdown) 2005. Legal Basis for Making the Order: s53(3)(c)(i) Wildlife and Countryside Act 1981.		Width 2.1m

Modification of Definitive Statement

Path Number: BC55/2
Ward / Parish: Lansdown

Status: Footpath
Width: Varies between 2.7m – 6.6m, as shown shaded on the Order Plan

Description of Route			
From	General Direction	To	Grid Ref:
County Road or Right of Way		County Road or Right of Way	Grid Ref:
St Stephen's Road	ST 7502 6592	NE	Rivers Road
			ST 7507 6600

General Description:

The footpath starts on St Stephen's Road and continues in a north easterly direction along a natural surface for a distance of approximately 95m to where it ends on Rivers Road.

Non Conclusive Evidence	Conditions and Limitations	Conclusive Evidential Provisions
Survey Date: 04/11/2004 and 16/05/2005		Previous Path Number: AQ196 Reason for inclusion: Order to be made under s53(3)(c)(i) Wildlife & Countryside Act 1981. Bath and North East Somerset Council, City of Bath Definitive Map and Statement Modification Order (No.2 - Lansdown) 2005. Legal Basis for Making the Order: s53(3)(c)(i) Wildlife and Countryside Act 1981.

Modification of Definitive Statement

Path Number: BC45/6
Ward / Parish: Lansdown

Status: Footpath
Width: Varies between 1.4m – 11.0m, as shown shaded on the Order Plan

Description of Route			
From	General Direction	To	Grid Ref:
County Road or Right of Way		County Road or Right of Way	
St Stephen's Road	ST 7491 6582	NNE	Mount Beacon
			ST 7504 6606

General Description:

The footpath starts on St Stephen's Road and continues in a north-north easterly direction, comprising a tarmac road with a paved pavement and a verge for a distance of approximately 108m where the direction changes to north easterly for a distance of approximately 16m to where the pavement and verge end and continues along a tarmac path for another 111m to where the direction changes to north-north easterly for a distance of approximately 42m to where the path ends on Mount Beacon.

Non Conclusive Evidence	Conditions and Limitations	Position	Conclusive Evidential Provisions
Survey Date: 04/11/2004 and 16/05/2005			
Previous Path Number: AQ327	Bollard	ST 7504 6606	3.4m
Reason for inclusion: Order to be made under s53(3)(c)(i) Wildlife & Countryside Act 1981. Bath and North East Somerset Council, City of Bath Definitive Map and Statement Modification Order (No 2 - Lansdown) 2005.			
Legal Basis for Making the Order: s53(3)(c)(i) Wildlife and Countryside Act 1981.			

Modification of Definitive Statement

Path Number: BC45/5
Ward / Parish: Lansdown

Status: Footpath
Width: Varies between ~~1.1m~~—~~6.5m~~, as shown shaded on the Order Plan
~~0.75m – 6.7m~~

Description of Route			
From	General Direction	To	Grid Ref:
County Road or Right of Way	Grid Ref:	County Road or Right of Way	Grid Ref:
St Stephen's Road	ST 7487 6590 ST 7486 6599	NE	Mount Road

General Description:

The footpath starts on St Stephen's Road, comprising a tarmac road with verges on either side and continues in a north easterly direction for a distance of approximately ~~98m~~ to where it ends on Mount Road. *The public rights only extend over the width of the tarmac road.*
~~101m~~

Non Conclusive Evidence	Conditions and Limitations	Position	Conclusive Evidential Provisions
Survey Date: 03/11/2004 and 16/05/2005			
Previous Path Number: AQ341			
Reason for inclusion: Order to be made under s53(3)(c)(i) Wildlife & Countryside Act 1981. Bath and North East Somerset Council, City of Bath Definitive Map and Statement Modification Order (No.2 - Lansdown) 2005.			
Legal Basis for Making the Order: s53(3)(c)(i) Wildlife and Countryside Act 1981.			

Modification of Definitive Statement

Path Number: BC45/4
Ward / Parish: Lansdown

Status: Footpath
Width: Varies between 1.5m – 4.4m, as shown shaded on the Order Plan

Description of Route			
From	General Direction	To	Grid Ref:
County Road or Right of Way		County Road or Right of Way	Grid Ref:
Park Street	ST 7450 6585	NE	All Saints Road
			ST 7455 6592

General Description:

The footpath starts on Park Street and continues in a north easterly direction along a paved path for a distance of approximately 10m to where the direction changes to east- north easterly for a distance of approximately 14m to 2 posts and continuing along a paved and tarmac path for a distance of approximately 24m to where the direction changes to northerly for a distance of approximately 46m to where it ends at 2 posts on All Saints Road.

Non Conclusive Evidence	Conditions and Limitations	Conclusive Evidential Provisions	
Survey Date: 03/11/2004 and 16/05/2005		Position	Width
Previous Path Number: AQ342 Reason for inclusion: Order to be made under s53(3)(c)(i) Wildlife & Countryside Act 1981. Bath and North East Somerset Council, City of Bath Definitive Map and Statement Modification Order (No.2 - Lansdown) 2005.	2 Posts 2 Posts	ST 7453 6586 ST 7455 6592	2.9m 3.7m

Legal Basis for Making the Order:
s53(3)(c)(i) Wildlife and Countryside Act 1981.

Modification of Definitive Statement

Path Number: BC46/2
Ward / Parish: Lansdown

Status: Footpath
Width: Varies between 3.2m – 3.4m, as shown shaded on the Order Plan

Description of Route			
From	General Direction	To	
County Road or Right of Way Northfields Close	Grid Ref: ST 7479 6623	E	County Road or Right of Way Richmond Road
			Grid Ref: ST 7483 6623

General Description:

The footpath starts at 2 staggered barriers on Northfields Close and continues along a tarmac path in an easterly direction for a distance of approximately 40m to another set of staggered barriers where it ends on Richmond Road.

Non Conclusive Evidence	Conditions and Limitations	Conclusive Evidential Provisions
Survey Date: 03/11/2004 and 16/05/2005		
Previous Path Number: BQ2 Reason for inclusion: Order to be made under s53(3)(c)(i) Wildlife & Countryside Act 1981. Bath and North East Somerset Council, City of Bath Definitive Map and Statement Modification Order (No 2 - Lansdown) 2005.	Staggered Barriers Staggered Barriers	ST 7479 6623 ST 7483 6623

Legal Basis for Making the Order:
s53(3)(c)(i) Wildlife and Countryside Act
1981.

Modification of Definitive Statement

Path Number: BC45/3
Ward / Parish: Lansdown

Status: Footpath
Width: Varies between 2.1m – 2.8m, as shown shaded on the Order Plan

Description of Route			
From	General Direction	To	
County Road or Right of Way	Grid Ref:	County Road or Right of Way	Grid Ref:
St Stephen's Road	ST 7485 6594	ENE	St Stephen's Close
			ST 7488 6595

General Description:

The footpath starts on St Stephen's Road and continues up a short flight of concrete steps in an east-north easterly direction for a distance of approximately 5m and continues for a further 23m along a tarmac path to where it ends on St Stephen's Close.

Non Conclusive Evidence	Conditions and Limitations	Conclusive Evidential Provisions
Survey Date: 03/11/2004 and 16/05/2005		
Previous Path Number: BQ20 Reason for inclusion: Order to be made under s53(3)(c)(i) Wildlife & Countryside Act 1981. Bath and North East Somerset Council, City of Bath Definitive Map and Statement Modification Order (No.2 - Lansdown) 2005. Legal Basis for Making the Order: s53(3)(c)(i) Wildlife and Countryside Act 1981.	Steps	ST 7485 6594 2.7m - 2.8m

Modification of Definitive Statement

Path Number: BC56/1 **Status:** Footpath
Ward / Parish: Lansdown **Width:** 1.8m, as shown shaded on the Order Plan

		Description of Route	
From	Grid Ref.	General Direction	To
County Road or Right of Way			County Road or Right of Way
Mount Beacon	ST 7508 6619	NE	Richmond Place

General Description:

The footpath starts on Mount Beacon and continues along a gravelled path in a north easterly direction for a distance of approximately 15m to 2 posts and continues along a natural surface for a distance of approximately 39m to where the direction changes to easterly and continues for a distance of approximately 46m to 4 posts where the path ends on Richmond Place.

Non Conclusive Evidence	Conditions and Limitations	Position	Conclusive Evidential Provisions
Survey Date: 04/11/2004 and 16/05/2005			
Previous Path Number: CQ13	2 Posts 4 Posts	ST 7509 6620 ST 7512 6623	Width
Reason for inclusion: Order to be made under s53(3)(c)(i) Wildlife & Countryside Act 1981. Bath and North East Somerset Council, City of Bath Definitive Map and Statement Modification Order (No 2 - Lansdown) 2005.			1.8m 1.8m
Legal Basis for Making the Order: s53(3)(c)(i) Wildlife and Countryside Act 1981.			

Modification of Definitive Statement

Path Number: BC45/7 **Status:** Footpath
Ward / Parish: Lansdown **Width:** Varies between 1.8m – 2.6m, as shown shaded on the Order Plan

Description of Route			
From	General Direction	To	
County Road or Right of Way	Grid Ref. of Way	County Road or Right of Way	Grid Ref.
St Stephen's Road	ST 7497 6581	E	St Stephen's Road ST 7499 6581

General Description:

The footpath starts on St Stephen's Road and continues down a flight of paved steps in a north easterly direction for a distance of approximately 2m to where the direction changes to east-north easterly for a distance of approximately 2m to where the surface changes to paved and tarmac and continues for a further 2m to where the direction changes to north easterly for a distance of approximately 12m and continues in a south-south easterly direction for a distance of approximately 12m where the surface becomes paved and continues for a further 4m to where it ends on St Stephen's Road.

Non Conclusive Evidence	Conclusive Evidential Provisions
Survey Date: 30/03/2005 & 16/05/2005	Conditions and Limitations
Previous Path Number: CQ57 Reason for inclusion: Order to be made under s53(3)(c)(i) Wildlife & Countryside Act 1981. Bath and North East Somerset Council, City of Bath Definitive Map and Statement Modification Order (No.2 - Lansdown) 2005. Legal Basis for Making the Order: s53(3)(c)(i) Wildlife and Countryside Act 1981.	Position ST 7497 6581 Width 1.9m – 2.5m

Wildlife & Countryside Act 1981

Bath & North East Somerset Council

Public Footpath AQ8 at Lansdown, Bath. City of Bath

Definitive Map and Statement Modification Order (No.2 - Lansdown) 2005

Bath & North East Somerset Council

Riverside

Temple Street

Keynsham

Bristol BS31 1LA

Tel 01225 477000

Key

A B C D E F G H
ST 7434 6601 ST 7436 6604

Map Number AQ8


Footpath to be added to the Definitive Map.
The width of the footpath to be recorded is
shown shaded.

Date: July 2005

Site Plan



Scale 1:500

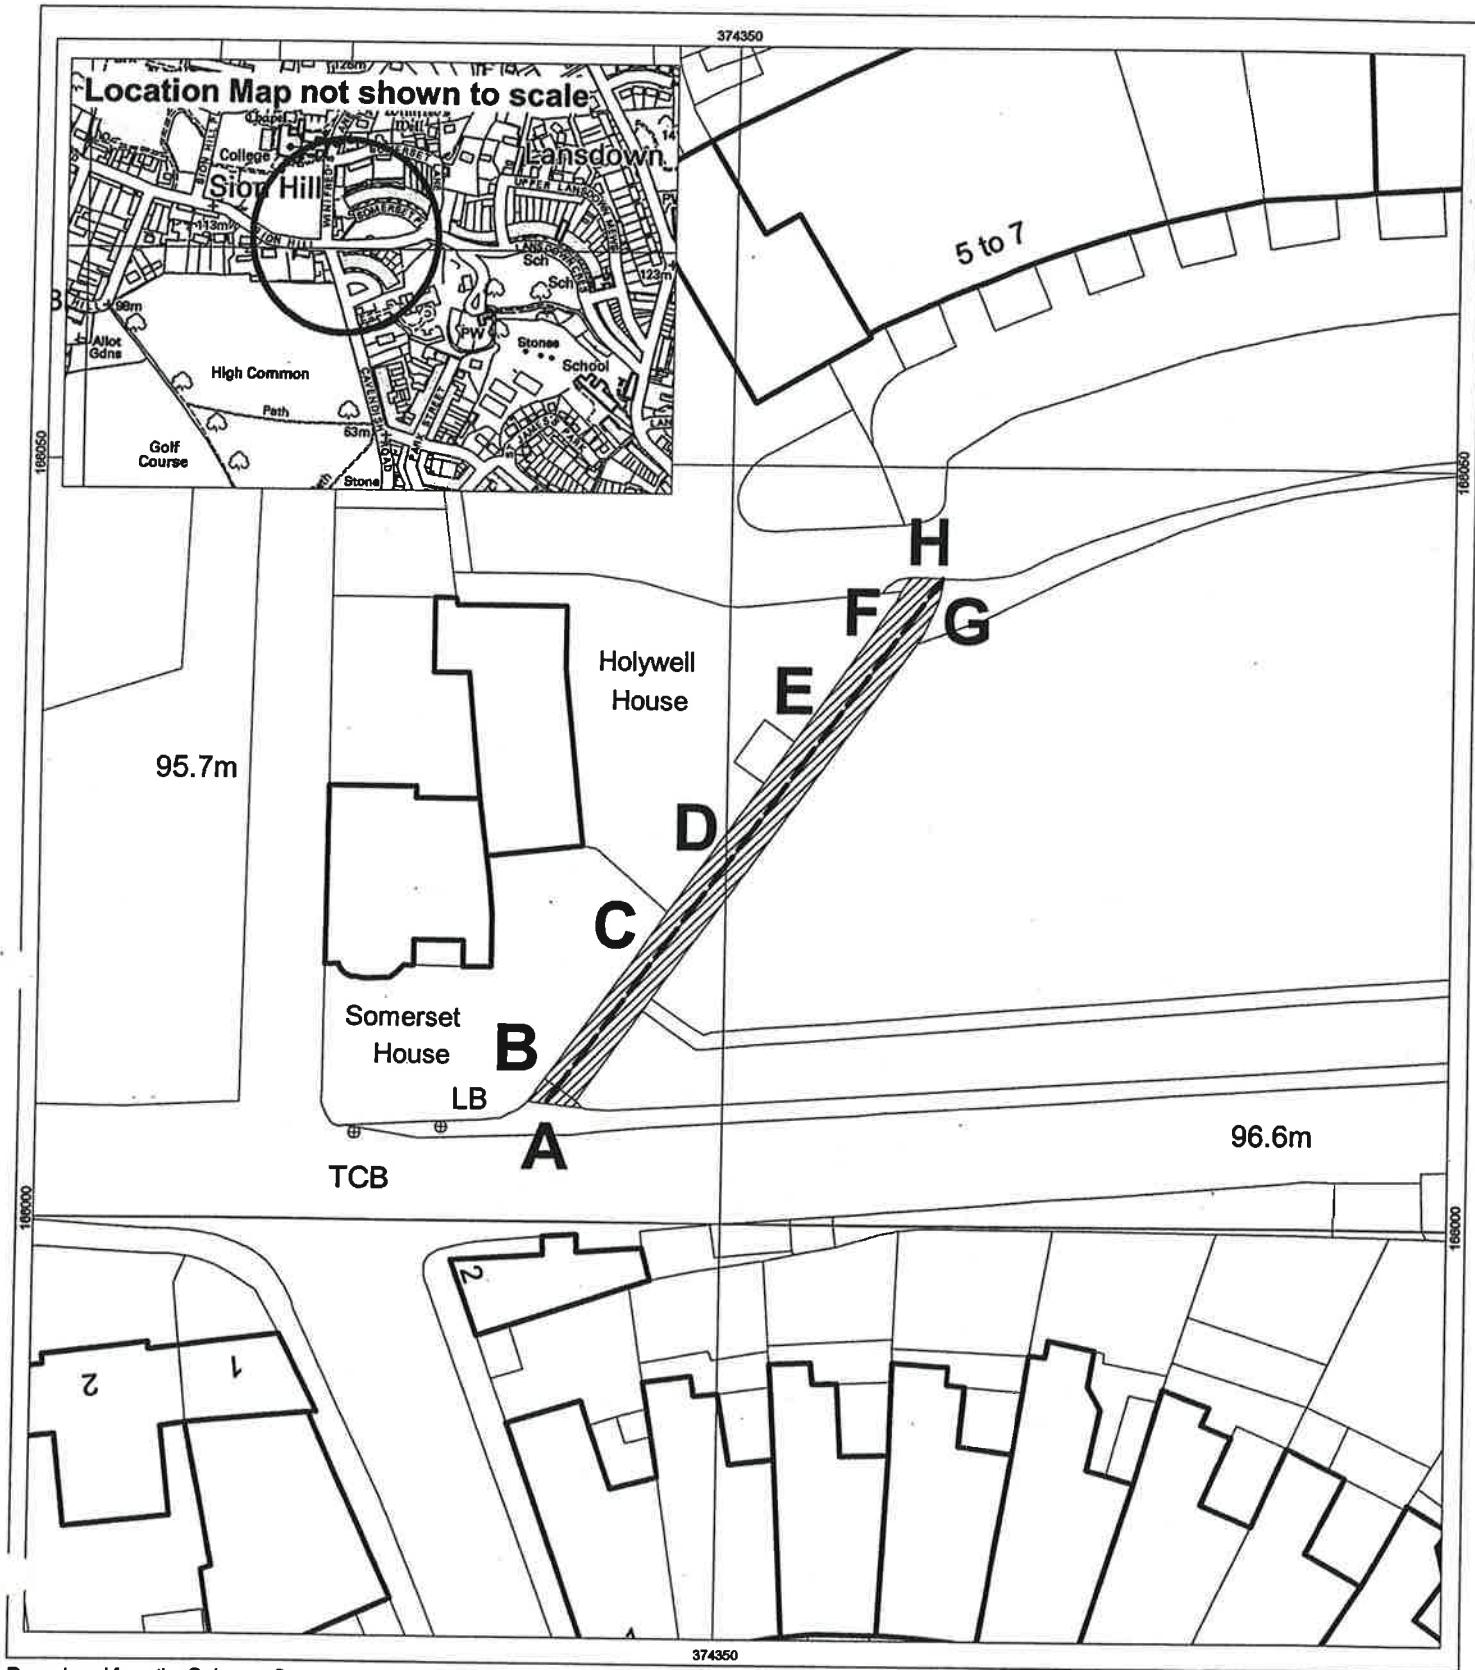

Wildlife & Countryside Act 1981

Bath & North East Somerset Council

Public Footpath AQ9 at Lansdown, Bath. City of Bath

Definitive Map and Statement Modification Order (No.2 - Lansdown) 2005

Bath & North East Somerset Council

Riverside

Temple Street

Keynsham

Bristol BS31 1LA

Tel 01225 477000

Key

A B C D E F G H

ST 7504 6607

ST 7506 6600

Map Number AQ9


Date: July 2005

Site Plan

N

Scale 1:1000

Footpath to be added to the Definitive Map.
The width of the public right of way to be
recorded is shown shaded

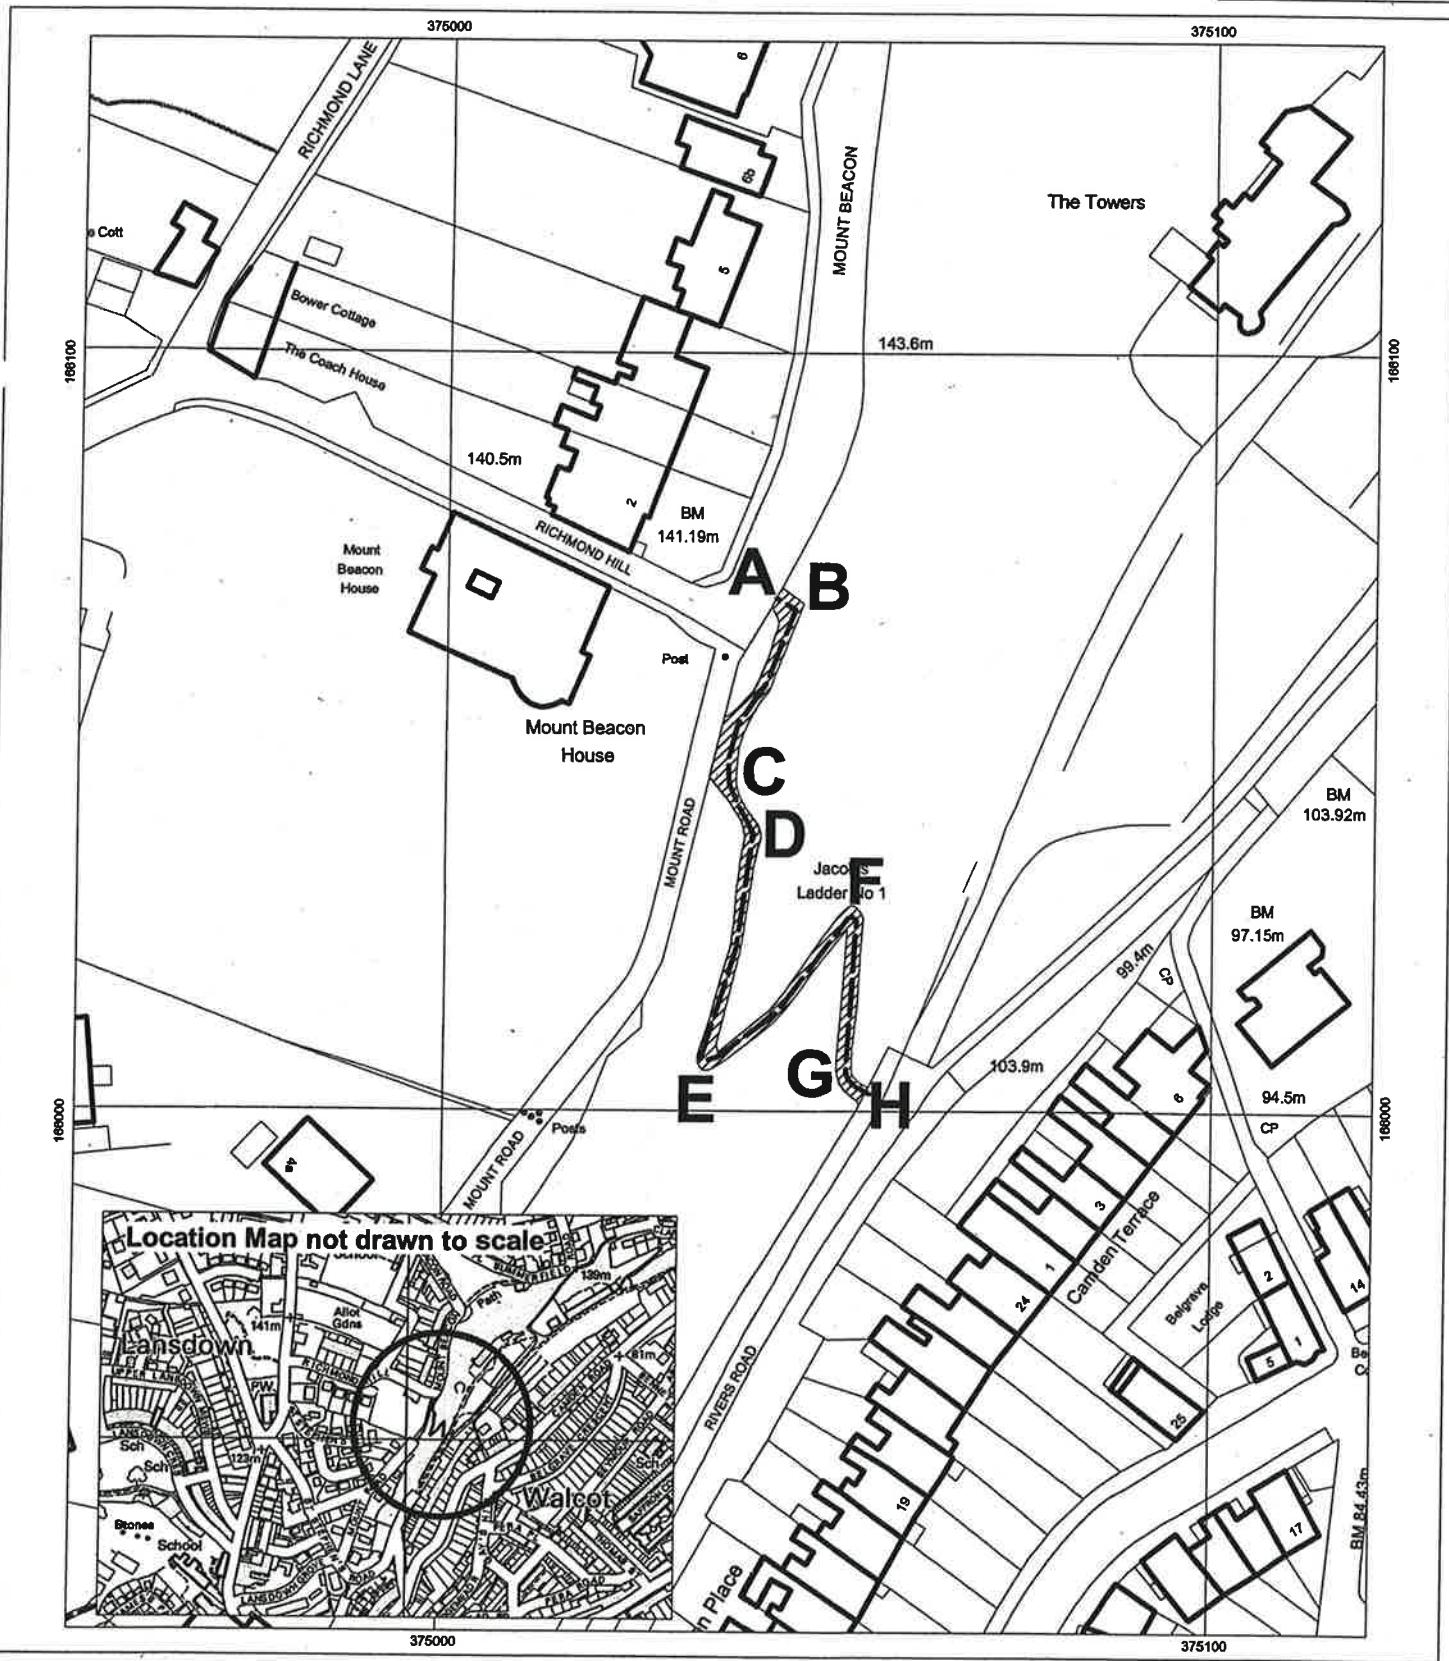

Wildlife & Countryside Act 1981

Bath & North East Somerset Council

Public Footpath AQ10 at Lansdown, Bath. City of Bath

Definitive Map and Statement Modification Order (No.2 - Lansdown) 2005

Bath & North East Somerset Council

Riverside

Temple Street

Keynsham

Bristol BS31 1LA

Tel 01225 477000

Key

A  B C D E
ST 7510 6604 ST 7512 6597

Map Number AQ10


Date: July 2005

Footpath to be added to the Definitive Map.
The width of the public right of way to be
recorded is shown shaded

Site Plan

Scale 1:500

N

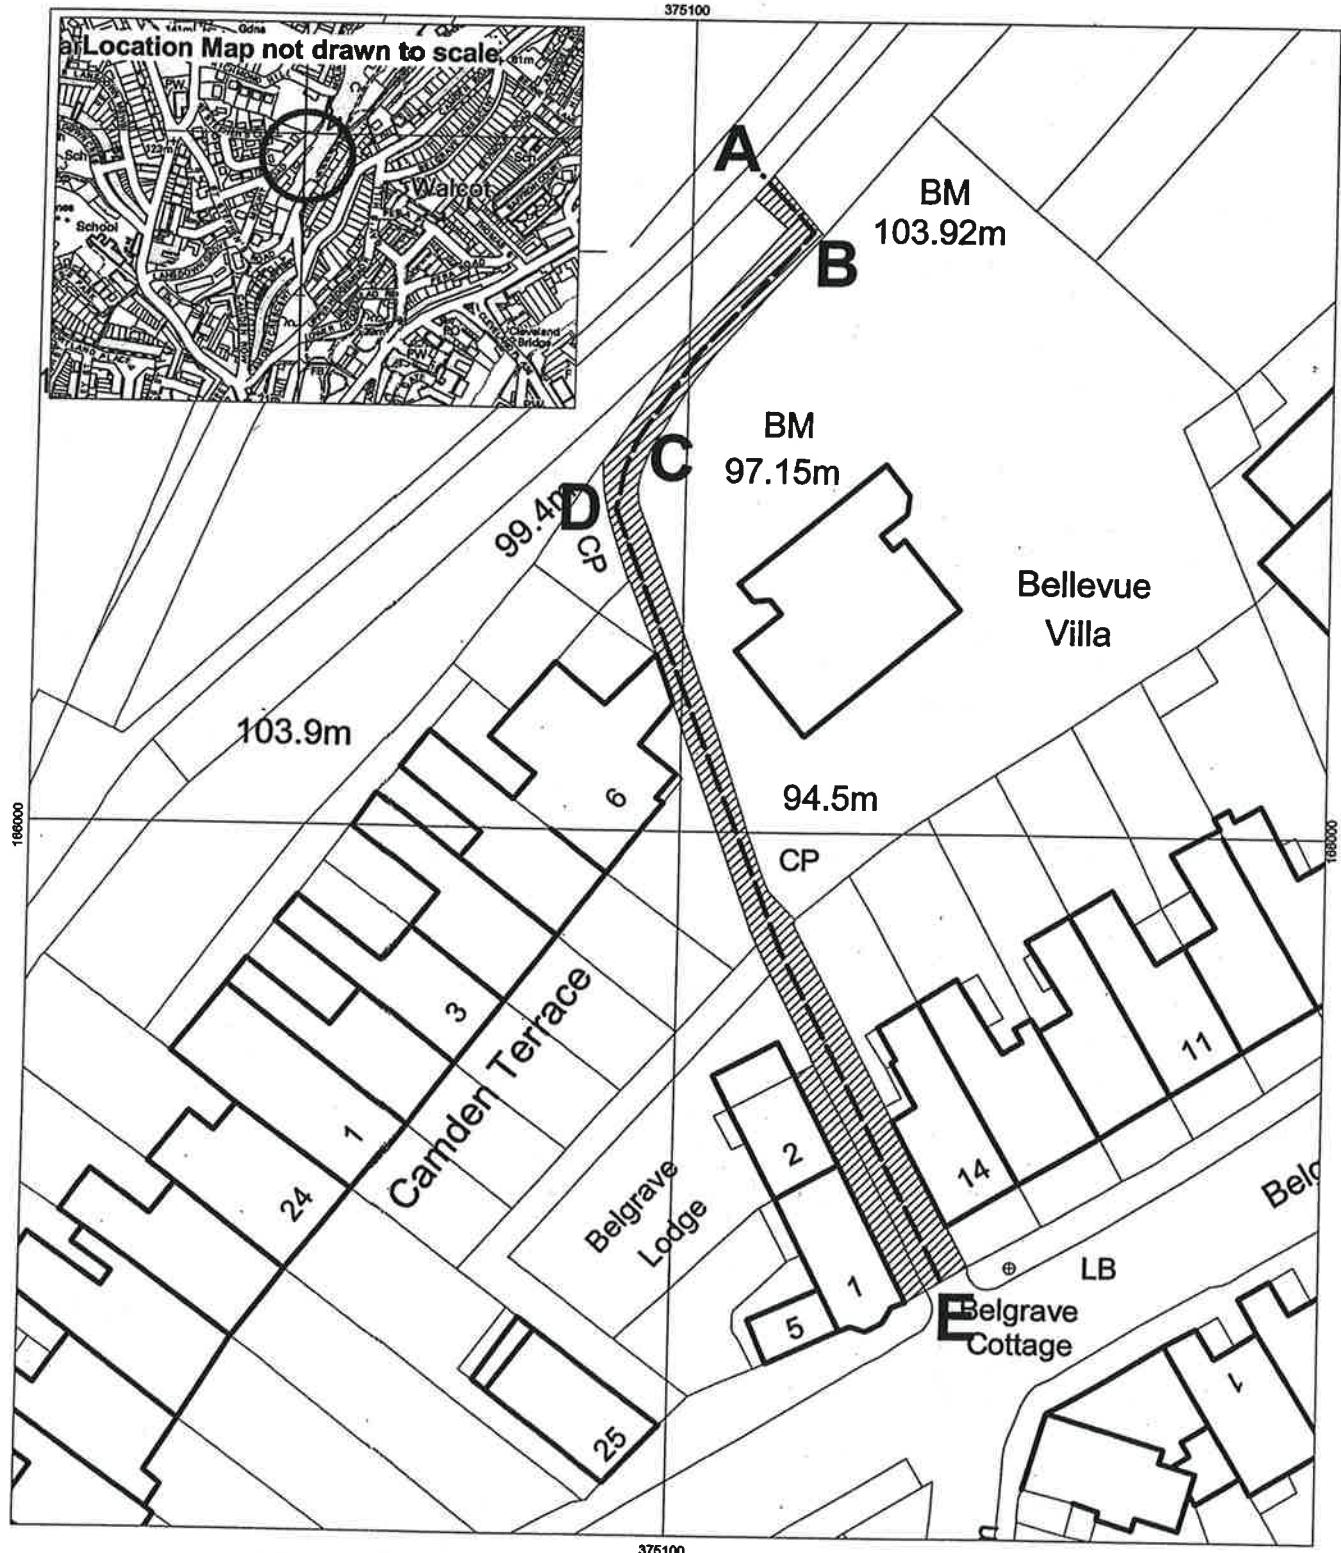

Wildlife & Countryside Act 1981

Bath & North East Somerset Council

Public Footpath AQ10a at Lansdown, Bath. City of Bath

Definitive Map and Statement Modification Order (No.2 - Lansdown) 2005

Bath & North East Somerset Council

Riverside


Temple Street

Keynsham

Bristol BS31 1LA

Tel 01225 477000

Key

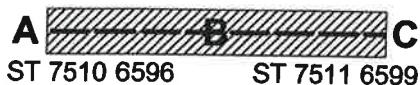

Map Number AQ10a



Date: July 2005

Site Plan

Scale 1:500



Footpath to be added to the Definitive Map.
The width of the public right of way to be
recorded is shown shaded.

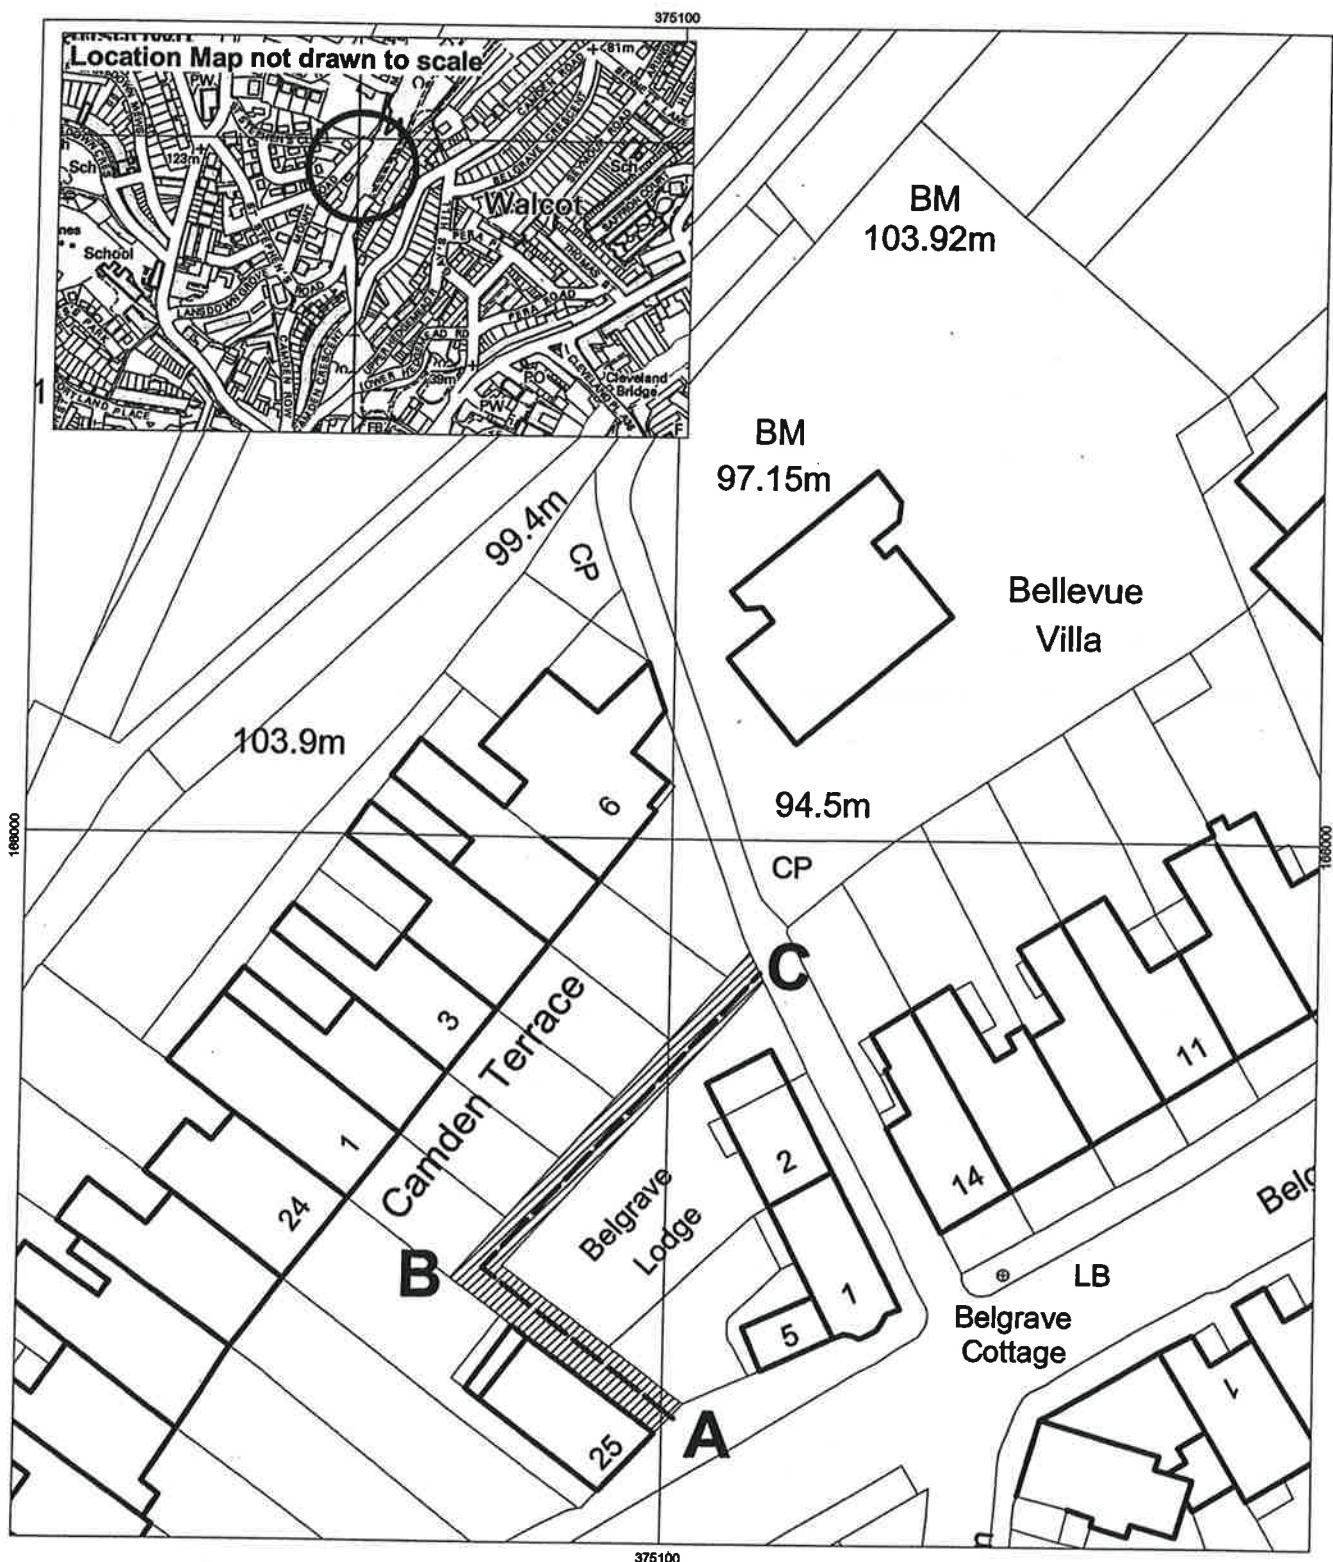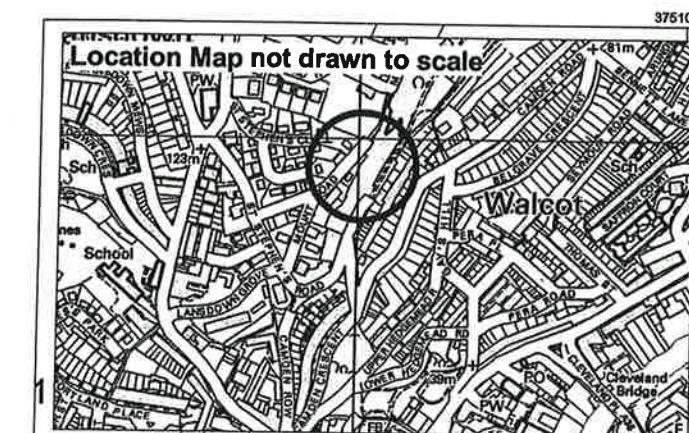

Wildlife & Countryside Act 1981

Bath & North East Somerset Council

Riverside

Temple Street

Keynsham

Bristol BS31 1LA

Tel 01225 477000

Bath & North East Somerset Council

Public Footpath AQ21 at Lansdown, Bath. City of Bath

Definitive Map and Statement Modification Order (No.2 - Lansdown) 2005

Date: July 2005

Site Plan




Scale 1:1000

Key

Map Number AQ21

A ————— B ————— C ————— D
ST 7468 6565 ST 7474 6575

Footpath to be added to the Definitive Map.
The width of the public right of way to be
recorded is shown shaded.

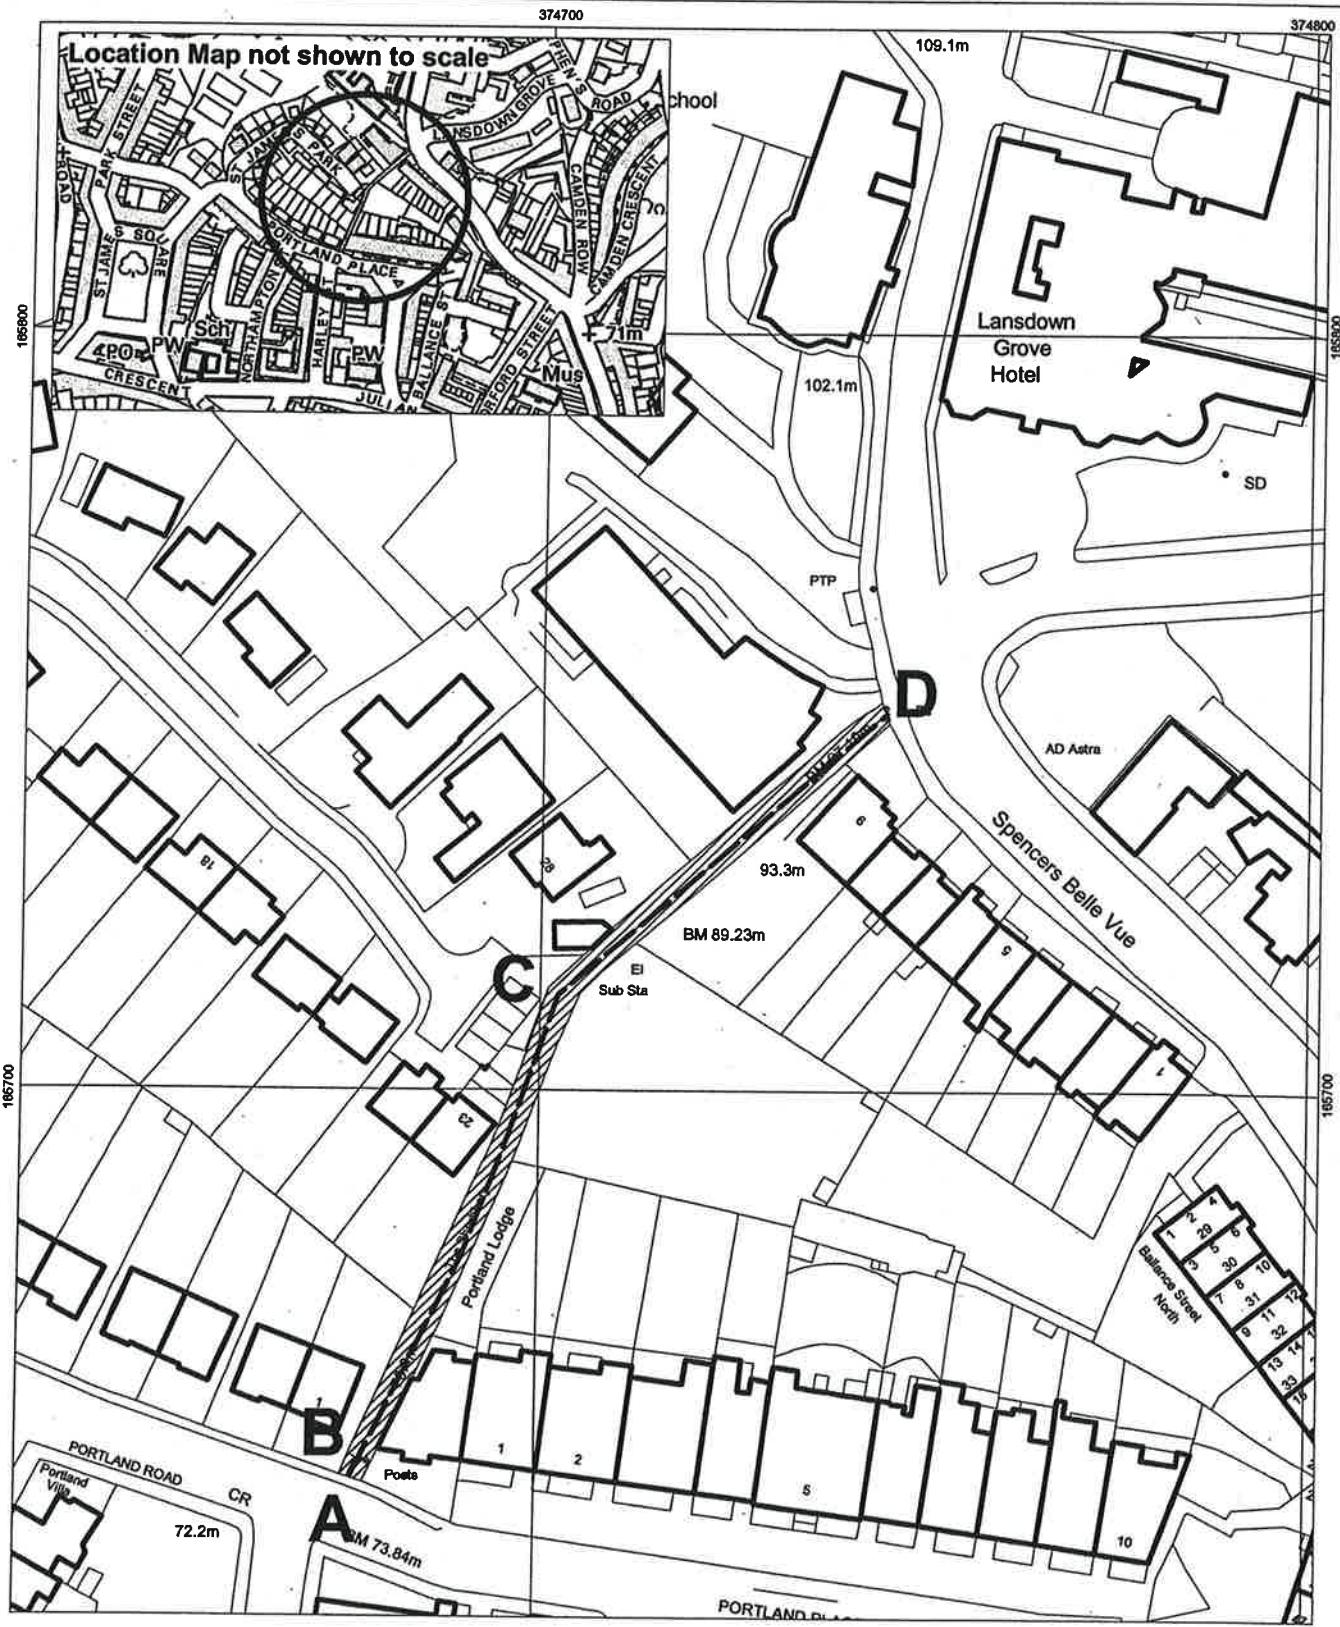

Wildlife & Countryside Act 1981

Bath & North East Somerset Council

Public Footpath AQ195 at Lansdown, Bath. City of Bath Definitive Map and Statement Modification Order (No.2 - Lansdown) 2005

Bath & North East Somerset Council

Riverside

Temple Street

Keynsham

Bristol BS31 1LA

Tel 01225 477000

Key




Map Number AQ195

Date: July 2005

Site Plan

N

Scale 1:500

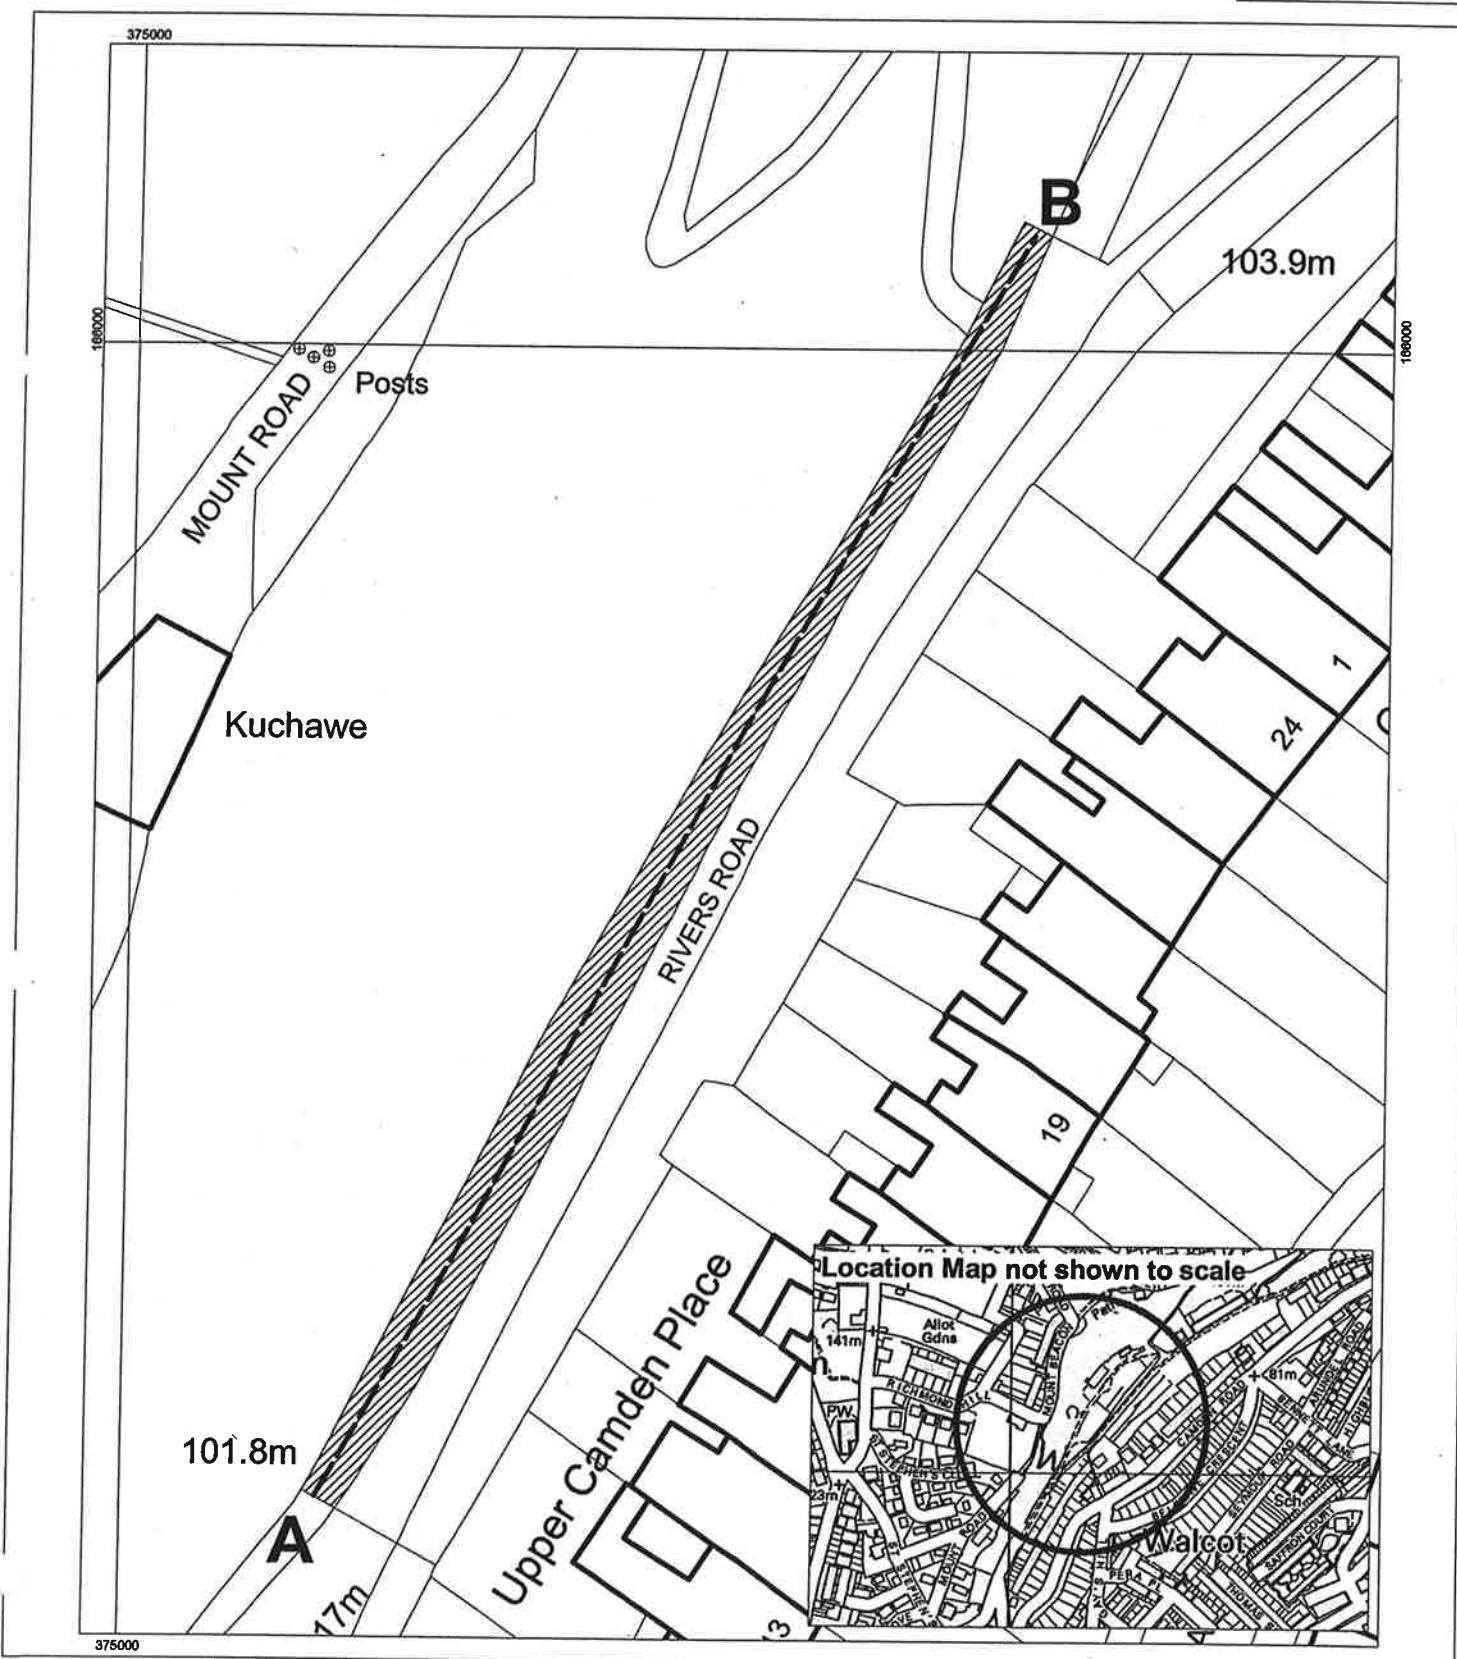

Wildlife & Countryside Act 1981

Bath & North East Somerset Council

Public Footpath AQ196 at Lansdown, Bath. City of Bath Definitive Map and Statement Modification Order (No.2 - Lansdown) 2005

Bath & North East Somerset Council

Riverside

Temple Street

Keynsham

Bristol BS31 1LA

Tel 01225 477000


Date: July 2005

Key



B

Footpath to be added to the Definitive Map.
The width of the public right of way to be
recorded is shown shaded.

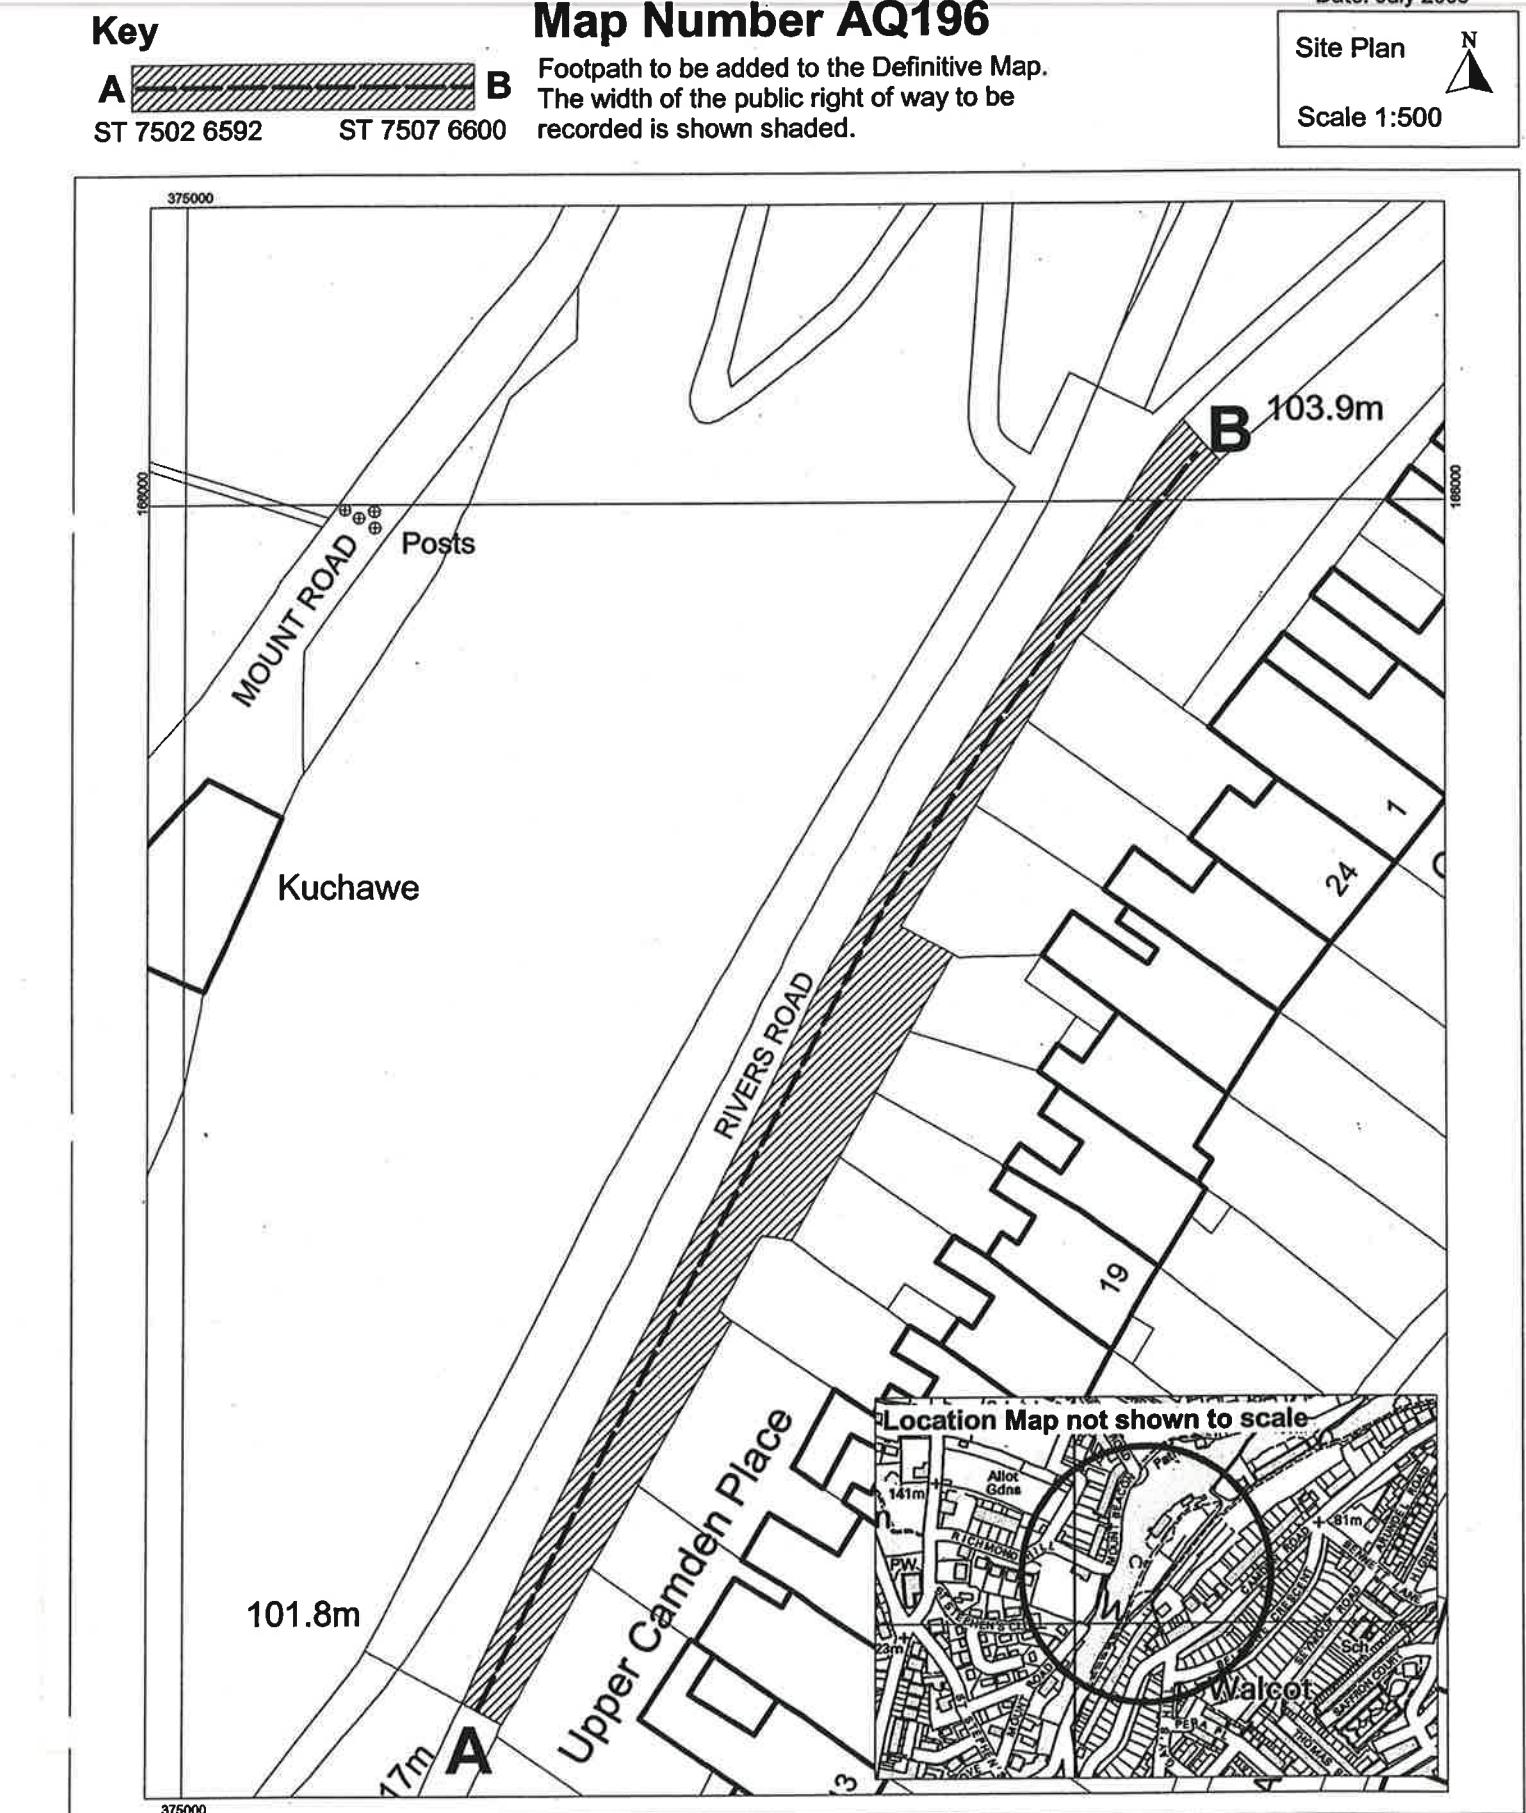

Wildlife & Countryside Act 1981

Bath & North East Somerset Council

Public Footpath AQ327 at Lansdown, Bath. City of Bath Definitive Map and Statement Modification Order (No.2 - Lansdown) 2005

Bath & North East Somerset Council

Riverside


Temple Street

Keynsham

Bristol BS31 1LA

Tel 01225 477000

Key

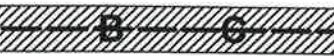A  C D
ST 7491 6582 ST 7504 6606

Map Number AQ327


Footpath to be added to the Definitive Map.
The width of the public right of way to be
recorded is shown shaded.

Date: July 2005

Site Plan



Scale 1:1250

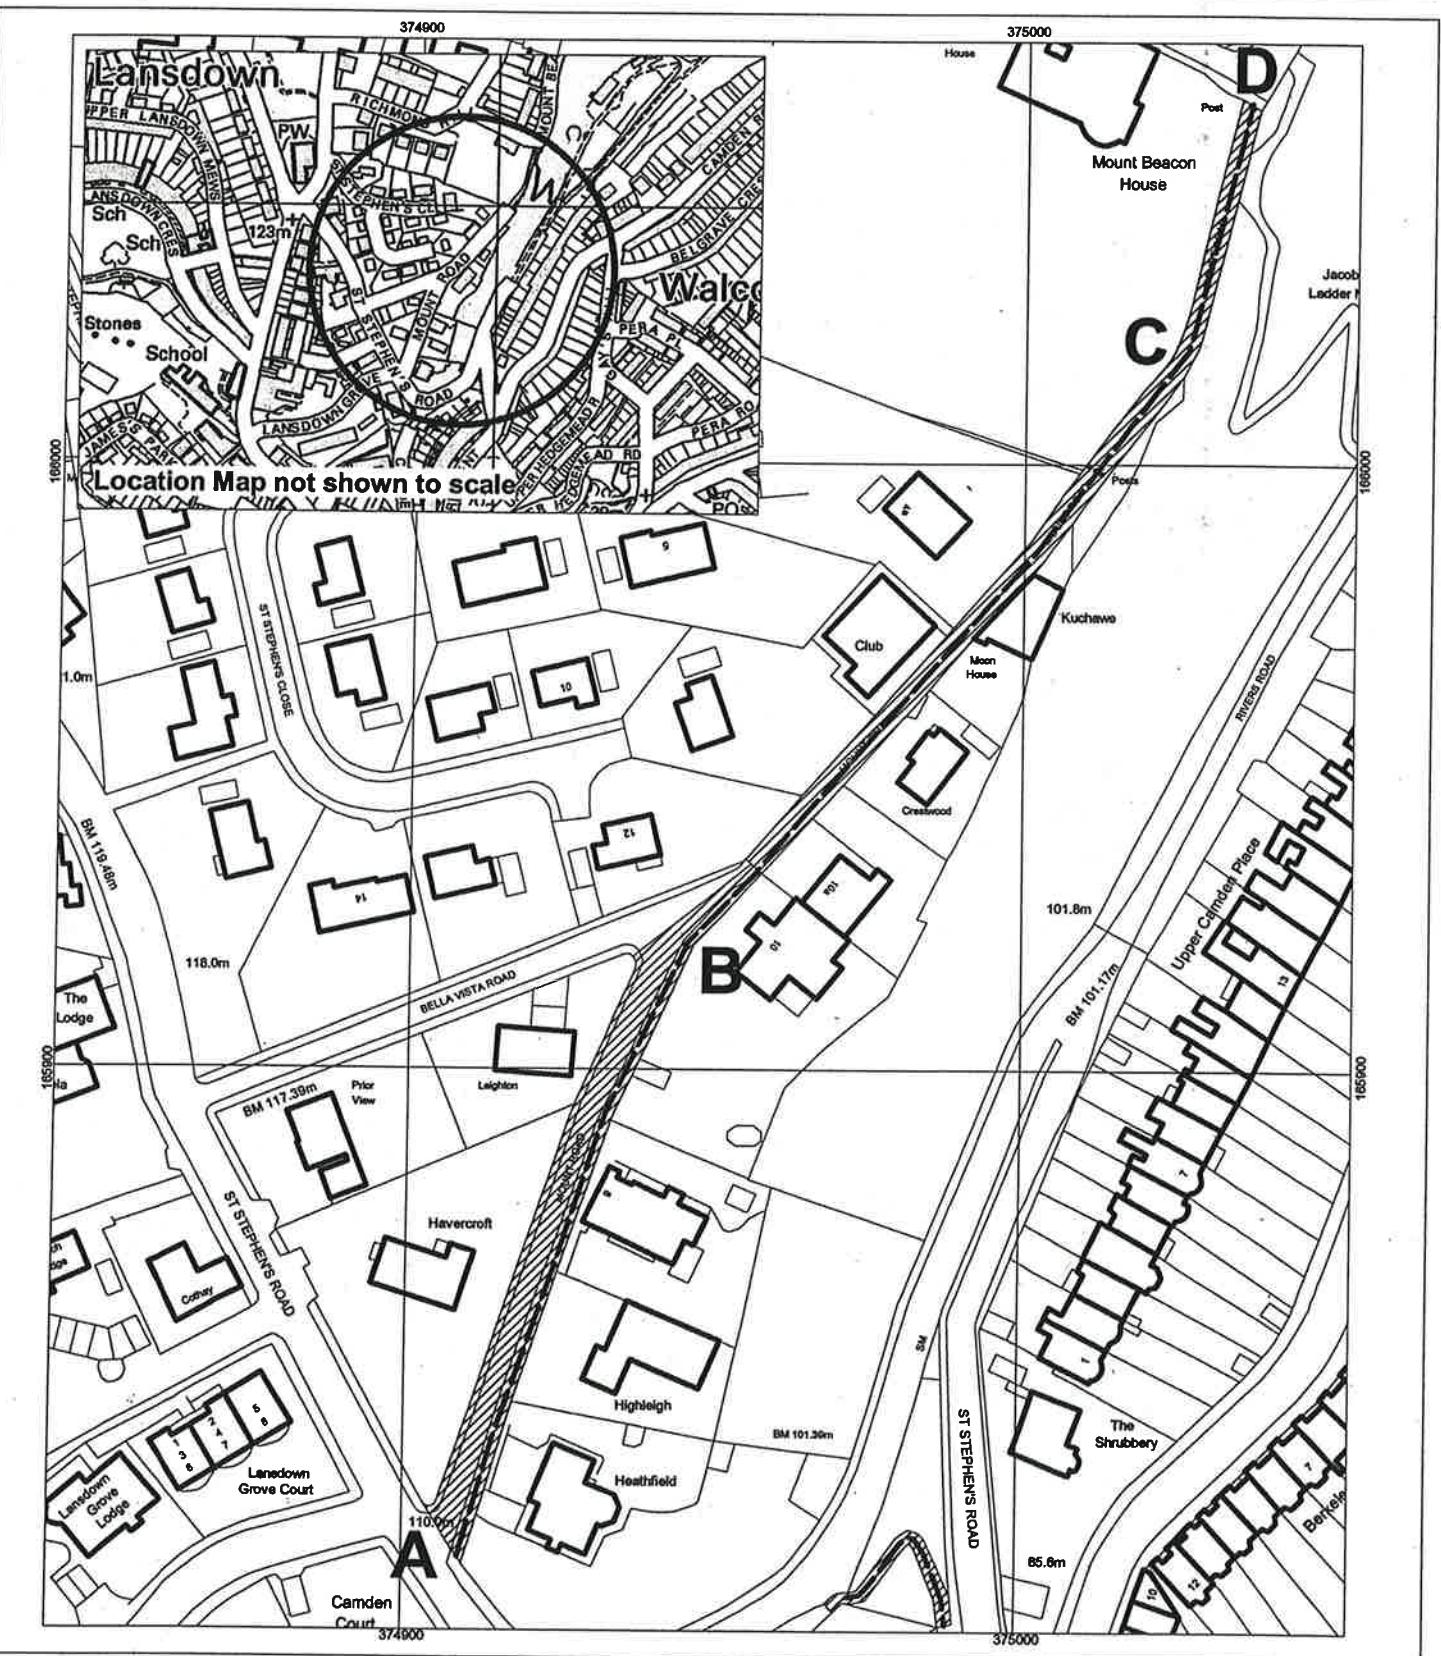

Wildlife and Countryside Act 1981

Bath and North East Somerset Council
Path AQ341 at Lansdown, Bath
City of Bath Definitive Map and Statement
Modification Order (No.2 - Lansdown)

Key



Date: July 2005
Site Plan
Scale 1:1000



ST 7487 6590
ST 7486 6559
Footpath to be added to Definitive Map.
The width of the public right of way to be
recorded is shown shaded.

0.75m to 6.7m

Map Number AQ341

Bath & North East Somerset Council
Riverside
Temple Street
Keynsham
Bristol BS31 1LA
Tel 01225 477000

A 4.6m
B 3.0m
C 2.8m
D 2.9m
E 3.0m
F 4.7m
G 0.75m



Wildlife & Countryside Act 1981

Bath & North East Somerset Council

Public Footpath AQ342 at Lansdown, Bath. City of Bath Definitive Map and Statement Modification Order (No.2 - Lansdown) 2005

Bath & North East Somerset Council

Riverside

Temple Street

Keynsham

Bristol BS31 1LA

Tel 01225 477000

Key

A B C D E
ST 7450 6585 ST 7455 6592

Map Number AQ342


Date: July 2005

Site Plan

N

Scale 1:1000

Footpath already added to the Definitive Map.

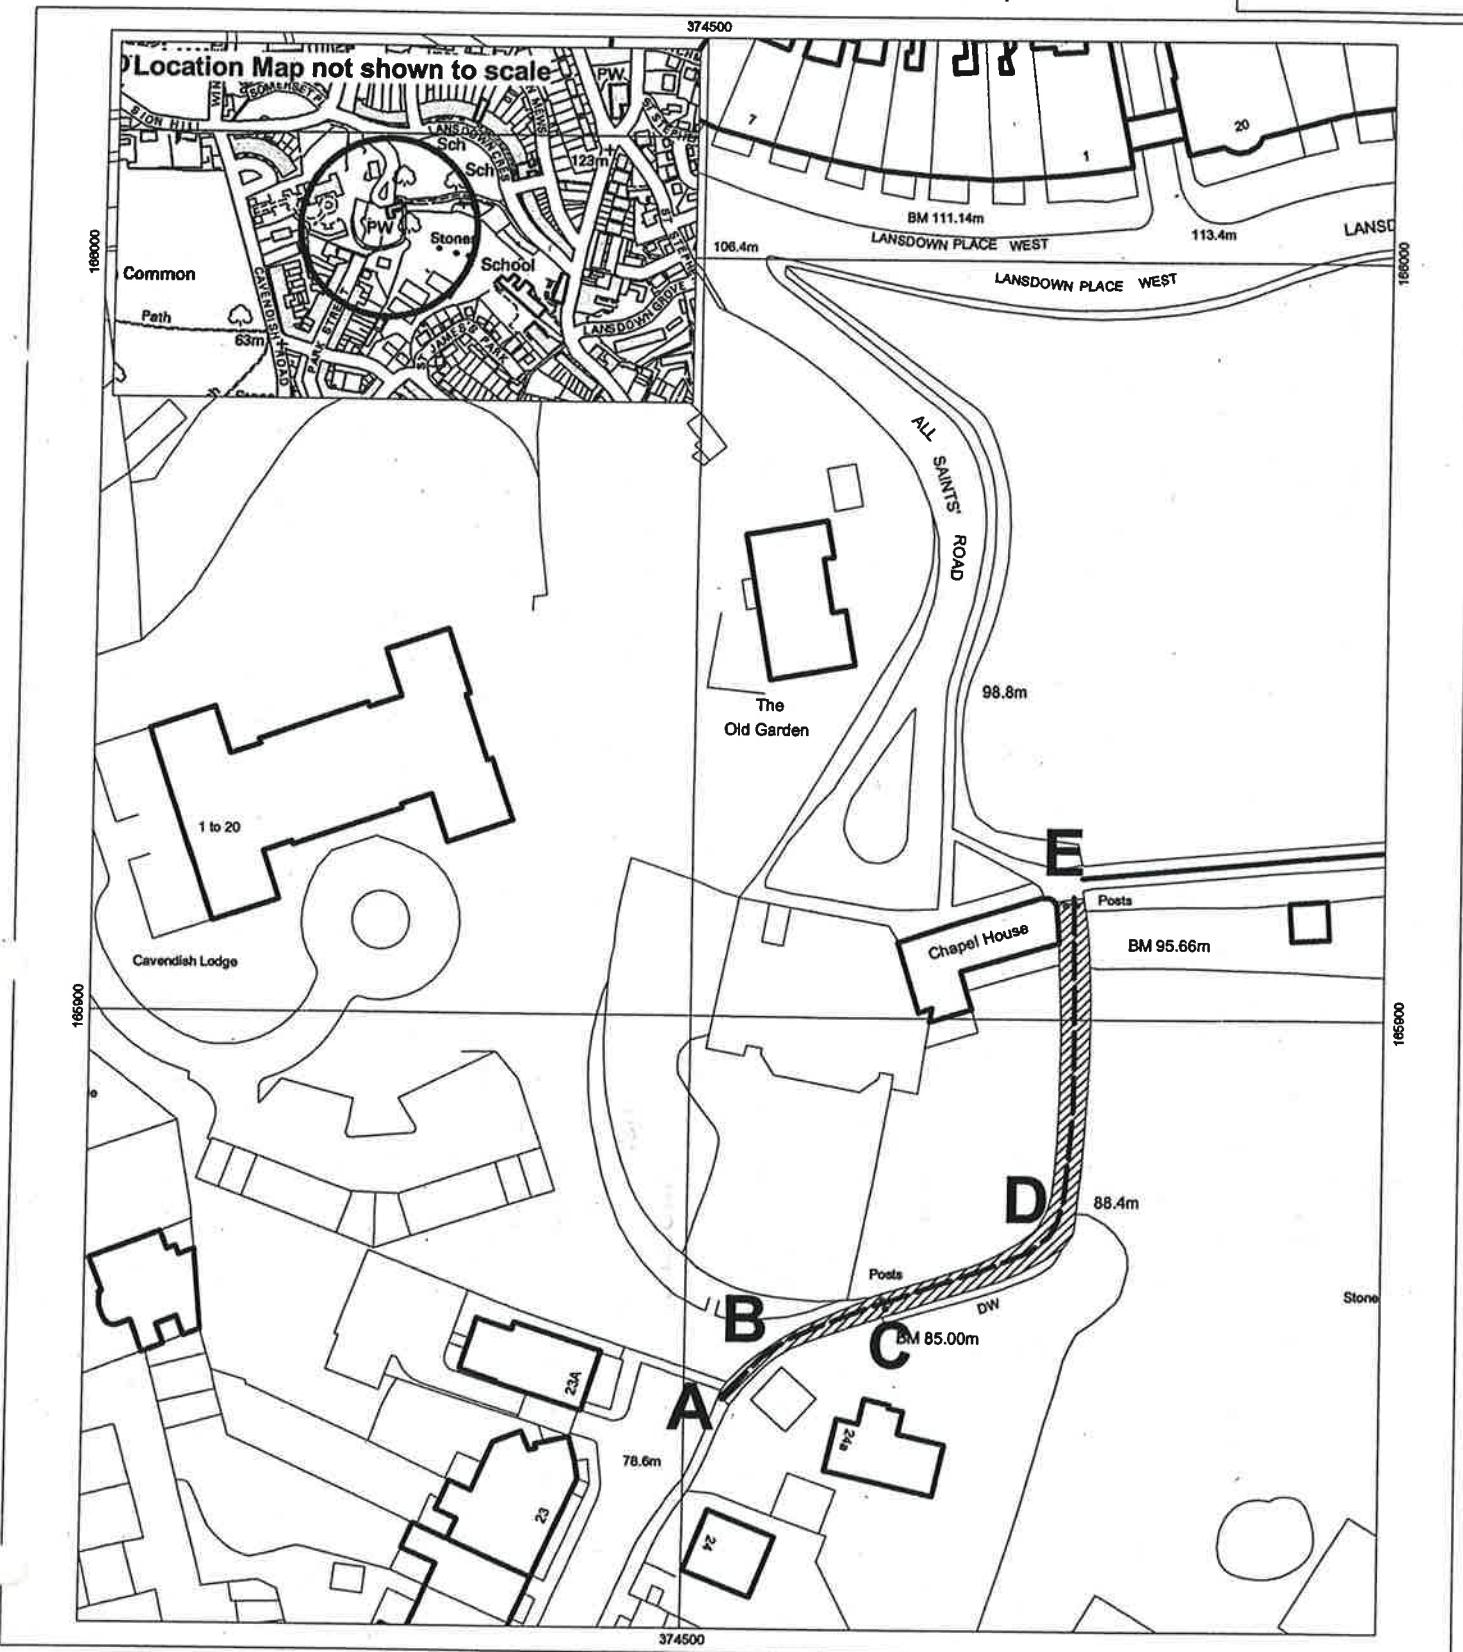

Wildlife and Countryside Act 1981

Bath and North East Somerset Council
Path BQ20 at Lansdown, Bath

City of Bath Definitive Map and Statement
Modification Order (No.2 - Lansdown)

Map Number BQ20

Key




Date: July 2005

Site Plan
Scale 1:500



Footpath to be added to Definitive Map.
The width of the public right of way to be
recorded is shown shaded.

Bath & North East Somerset Council
Riverside
Temple Street
Keynsham
Bristol BS31 1LA
Tel 01225 477000

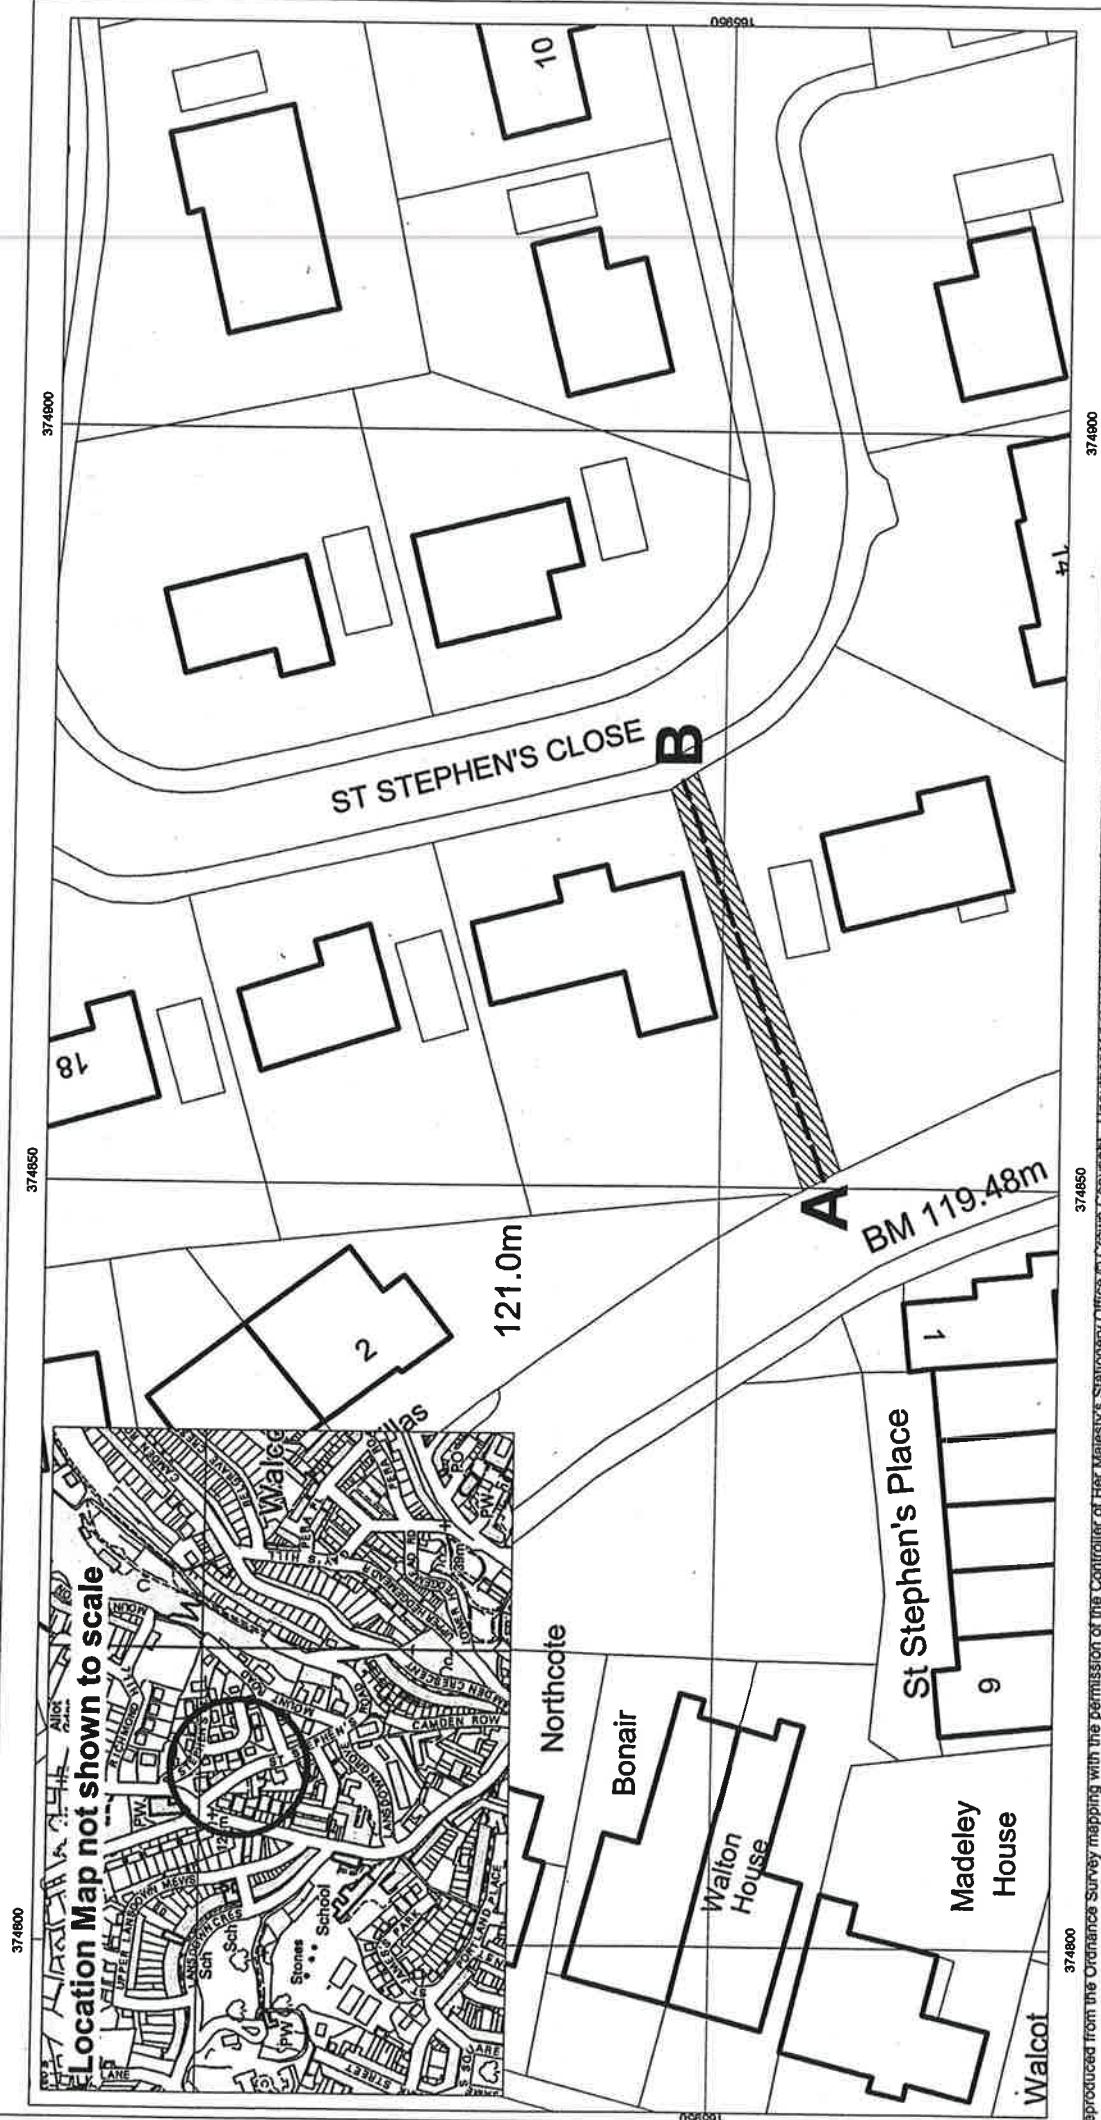

Wildlife and Countryside Act 1981

Bath and North East Somerset Council
Path CQ13 at Lansdown, Bath
City of Bath Definitive Map and Statement
Modification Order (No.2 - Lansdown)

Map Number CQ13

Date: July 2005

Site Plan
Scale 1:1000




Key

A —— B —— C —— D
ST 7508 6619 ST 7515 6623

Footpath to be added to the Definitive Map.
The width of the public right of way to be
recorded is 1.8m.

Bath & North East Somerset Council
Riverside
Temple Street
Keynsham
Bristol BS31 1LA
Tel 01225 477000

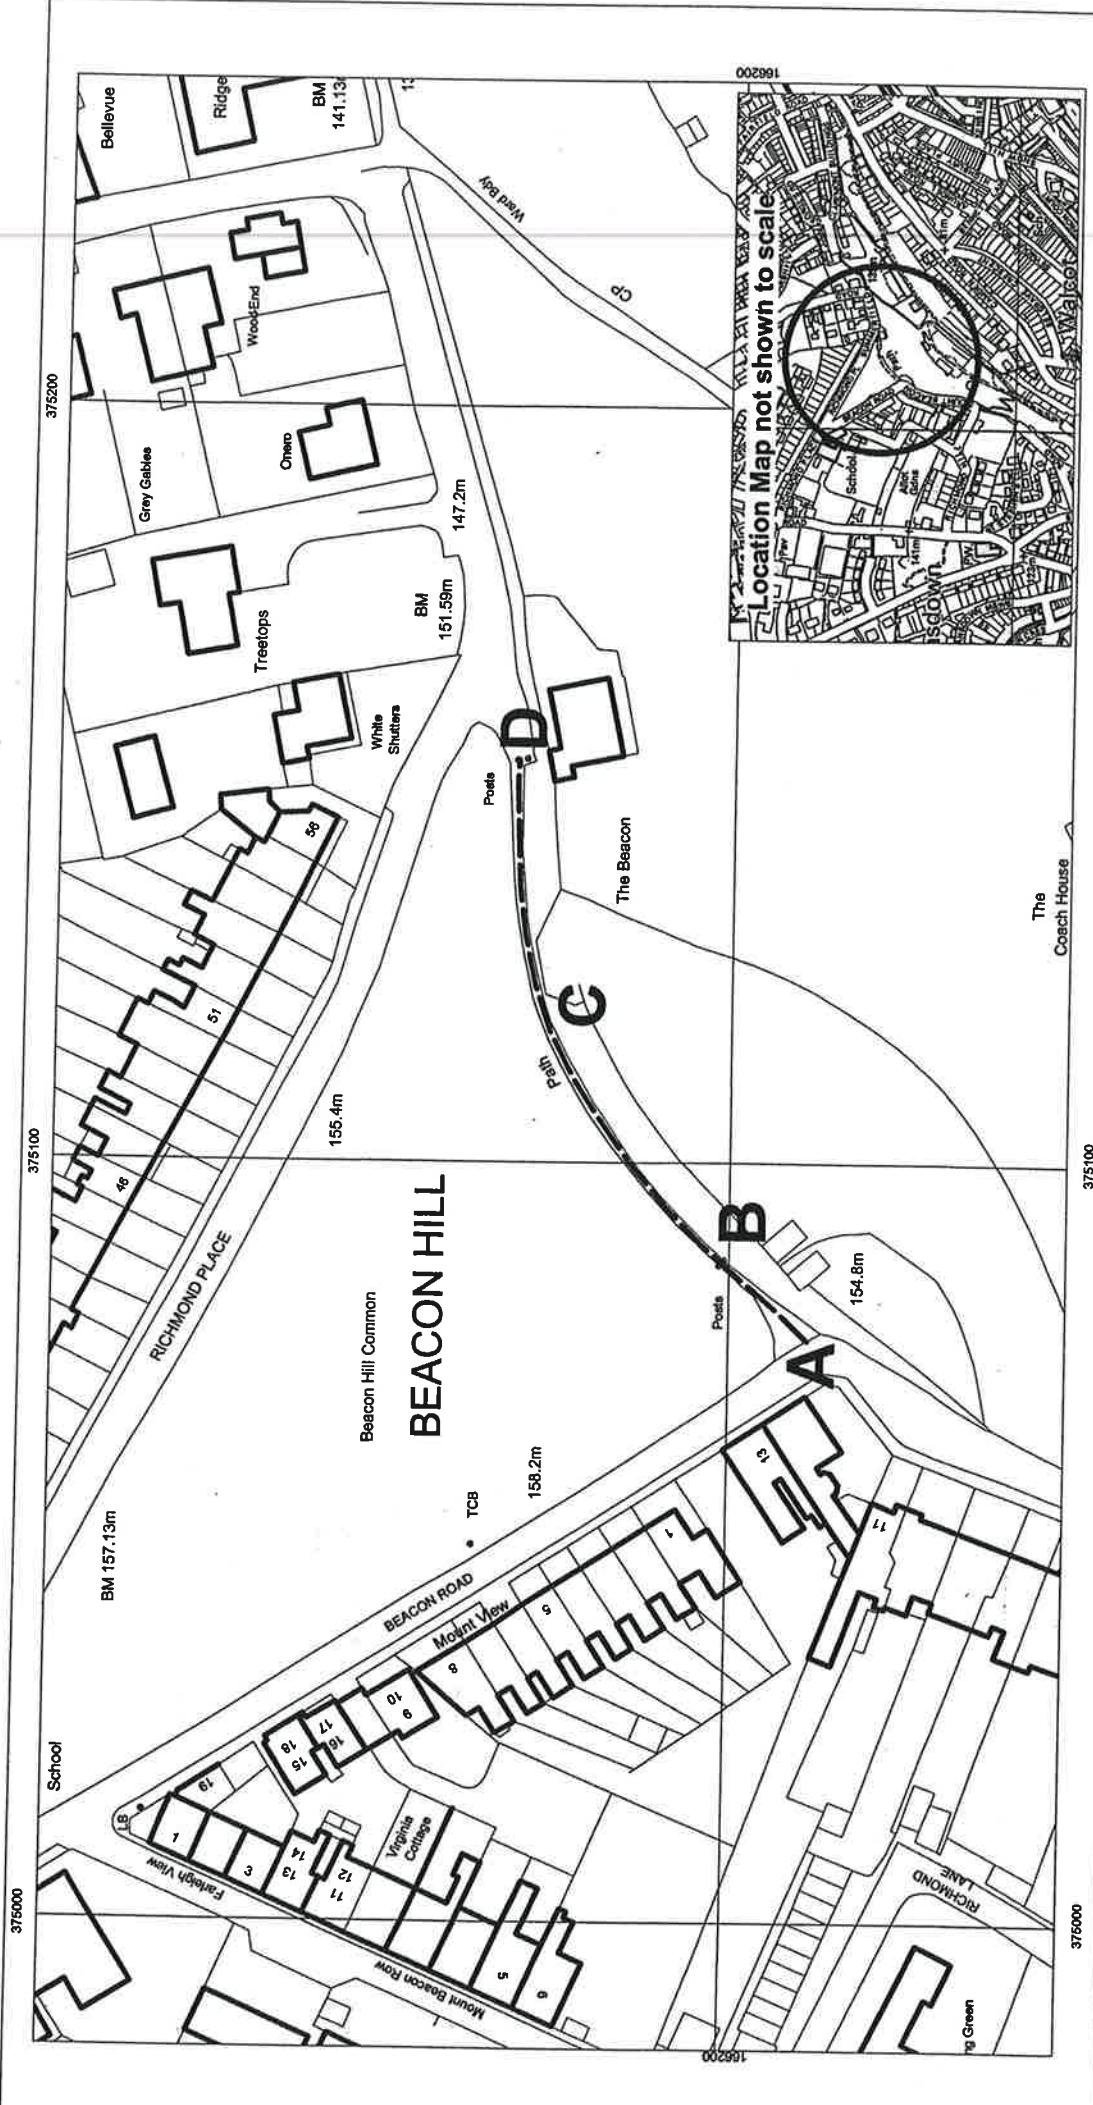

Wildlife & Countryside Act 1981

Bath & North East Somerset Council

Public Footpath CQ57 at Lansdown, Bath. City of Bath Definitive Map and Statement Modification Order (No.2 - Lansdown) 2005

Bath & North East Somerset Council

Riverside

Temple Street

Keynsham

Bristol BS31 1LA

Tel 01225 477000

Date: July 2005

Map Number CQ57

Key

Footpath to be added
to Definitive Map




The width of the path to be recorded is shown shaded

Site Plan

N

Scale 1:500

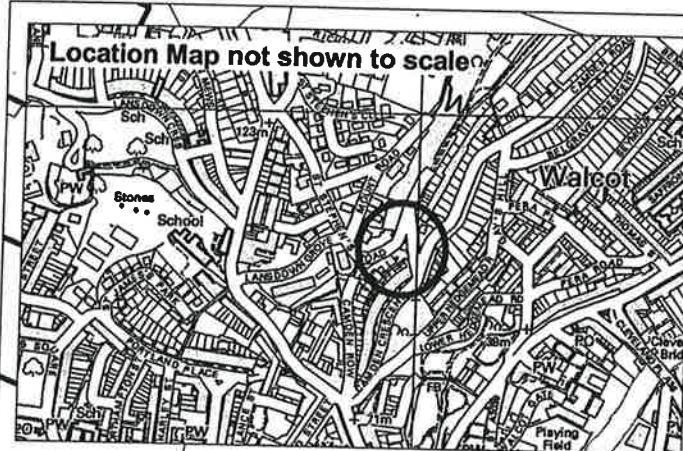

leigh

nfield

BM 101.39m

ST STEPHEN'S ROAD

85.6m

The
Shrubbery

105000

A B C E

21

375000

105000

5

105000